

MISSISSIPPI DEPARTMENT OF NATURAL RESOURCES

Bureau of Land and Water Resources

Southport Mall

P.O. Box 10631

Jackson, Mississippi 39209

WATER WELL DRILLERS LOG

Marshall
B
2031

10-30 1980 / Bob Smith / Marshall
 date well completed firm name county well located

LANDOWNER:	description of formations encountered	from	to
Freddie Copeland	top soil	0	5
mt. Pleasant	red clay	5	50
(mailing address)	white clay	50	125
	sand	125	170

WELL LOCATION:
 sec. 35 T 8 N R 3 E
 0 miles of mt. Pleasant
 (distance) (direction) (nearest town)

WELL PURPOSE:
 (home, irrigation, municipal, industrial)

WELL COMPLETION DATA:

(1) diameter (inches) 4 1/2

(2) total depth (feet) 170'

(3) static water level (feet) 140' below top of ground

(4) casing plastic 170' (material) (depth)

if telescope see back.

(5) screen 90' length, 150' depth to top
 4 1/2" size, plastic material

(6) pump 1/2 HP, 10 yield gpm
 electric type power

(7) electric log (yes or no)

(organization running log)

(8) how well bottom plugged Cap


DRILLERS REMARKS:

DEPT. OF NATURAL RESOURCES
 BUREAU OF LAND & WATER RESOURCES

OCT 12 1982
 RECEIVED

If well telescopes please sketch and show depths.

GROUND LEVEL

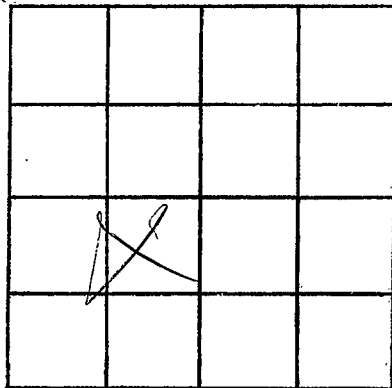

SECTION _____

Please indicate well location X.

ADDITIONAL INFORMATION

If more than one screen,
show locations of each on sketch.