

MISSISSIPPI DEPARTMENT OF NATURAL RESOURCES
 Bureau of Land and Water Resources
 Southport Mall
 P.O. Box 10631
 Jackson, Mississippi 39209
WATER WELL DRILLERS LOG

Marshall
B 2032

9-25-1984 Wilson Well Co. Inc. Marshall
 date well completed firm name county well located

LANDOWNER: Jessie Rubin
Mt. Pleasant, MS. 38609
 (mailing address)

WELL LOCATION:
 sec 35 T 1 N R 3 E
3 miles E of Patuxent
 (distance) (direction) (nearest town)

description of formations encountered	from	to
Brown Clay	0	10
Red SAND	10	30
White SAND	30	40
White SAND white clay	40	45
White SAND	45	105
White Clay	105	117
White SAND	117	163

WELL PURPOSE: Home
 (home, irrigation, municipal, industrial)

- WELL COMPLETION DATA:
- (1) diameter (inches) 4
 - (2) total depth (feet) 163
 - (3) static water level (feet) 95 below top of ground.
 - (4) casing PLASTIC, 163
 (material) (depth)
4 if telescope see back.
 (size)
 - (5) screen 10,
 (length) (depth to top)
4, PLASTIC
 (size) (material)
 - (6) pump 3/4, 12
 (HP) (yield gpm)
Elec.
 (type power)
 - (7) electric log NO
 (yes or no)
 (organization running log)
 - (8) how well bottom plugged 4-PLUGGED

DEPT. OF NATURAL RESOURCES
 BUREAU OF LAND & WATER RESOURCES


OCT 25 1984

RECEIVED

DRILLERS REMARKS:

If well telescopes please
sketch and show depths.

GROUND LEVEL

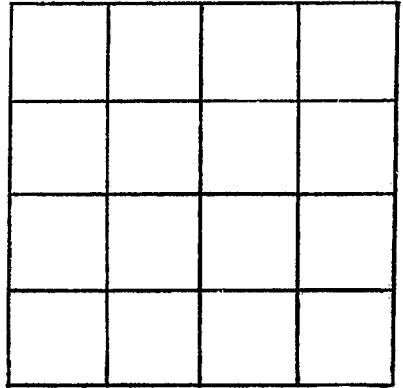

SECTION _____

Please indicate well location X.

ADDITIONAL INFORMATION

If more than one screen,
show locations of each on sketch.