

MISSISSIPPI DEPARTMENT OF NATURAL RESOURCES

Bureau of Land and Water Resources

Southport Mall

P.O. Box 10631

Jackson, Mississippi 39209

WATER WELL DRILLERS LOG

MARSHALL
B2033

5-23
date well completed

1985 Larry Carpenter Well Co.
firm name

Marshall
county well located

LANDOWNER: Billy Ruff
Red Barber, Jr
RFD
(mailing address)

description of formations encountered

from to

Sandy Soil 0 20

Med Red Sand 20 35

Med. White Sand 35 60

White Clay 60 85

Fine White Sand 85 100

White Coarse Sand 100 126

WELL LOCATION:

sec 32 T 1 N R 3 E
S W
1 miles West of Waltham
(distance) (direction) (nearest town)

WELL PURPOSE: Home
(home, irrigation, municipal, industrial)

WELL COMPLETION DATA:

(1) diameter (inches) 4

(2) total depth (feet) 126

(3) static water level (feet) 70 below above top of ground.

(4) casing PVC, 116'
(material) (depth)

(size) if telescope see back.

(5) screen 10', 116'
(length) (depth to top)

4 in, PVC
(size) (material)

(6) pump 1/2, 10
(HP) (yield gpm)

Elec
(type power)

(7) electric log no
(yes or no)

(organization running log)


(8) how well bottom plugged PVC Cap

DRILLERS REMARKS:

RECEIVED
JUL 23 1986
Department of Natural Resources
Bureau of Land & Water Resources

If well telescopes please sketch and show depths.

GROUND LEVEL

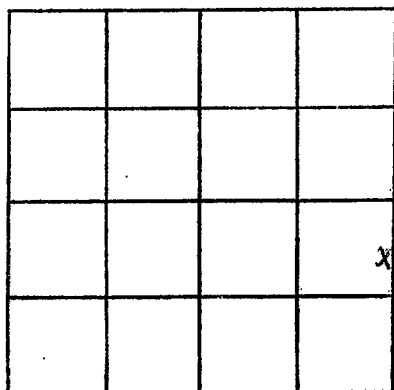

SECTION 32

Please indicate well location X.

ADDITIONAL INFORMATION

If more than one screen,
show locations of each on sketch.