

MISSISSIPPI DEPARTMENT OF NATURAL RESOURCES

Bureau of Land and Water Resources

Southport Mall

P.O. Box 10631

Jackson, Mississippi 39209

WATER WELL DRILLERS LOG

MARSHALL  
B 2034

7-16  
date well completed

19 85 Larry Carpenter Wells  
firm name

Marshall  
county well located

LANDOWNER: Dese Pollock

Red Bank, Miss.

RFD  
(mailing address)

description of formations encountered	from	to
<u>Surface Soil</u>	<u>0</u>	<u>20</u>
<u>Red Red Sand</u>	<u>20</u>	<u>39</u>
<u>Red, white Sand</u>	<u>39</u>	<u>65</u>
<u>White Clay</u>	<u>65</u>	<u>90</u>
<u>Fine white Sand</u>	<u>90</u>	<u>130</u>
<u>White coarse Sand</u>	<u>130</u>	<u>160</u>

WELL LOCATION:

sec. 33 T 1 N R 3 E  
S W  
1/2 miles West of Mt Pleasant  
(distance) (direction) (nearest town)

WELL PURPOSE: Home  
(home, irrigation, municipal, industrial)

WELL COMPLETION DATA:

- (1) diameter (inches) 4
- (2) total depth (feet) 160
- (3) static water level (feet) 95 below above top of ground.
- (4) casing PVC, 150'  
(material) (depth)  
(size) if telescope see back.
- (5) screen 10', 150'  
(length) (depth to top)  
4 in., PVC  
(size) (material)
- (6) pump 1/2, 10  
(HP) (yield gpm)  
Elec.  
(type power)
- (7) electric log No.  
(yes or no)  
(organization running log)
- (8) how well bottom plugged PVC Cap

RECEIVED


JUL 23 1986

Department of Natural Resources  
Bureau of Land & Water Resources

DRILLERS REMARKS:

If well telescopes please sketch and show depths.

GROUND LEVEL

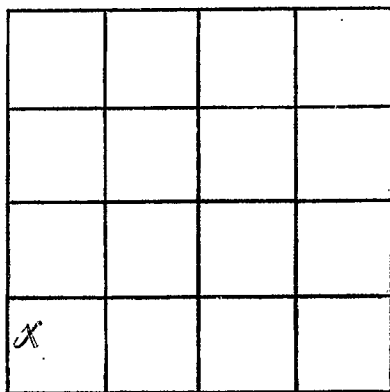

SECTION 33

Please indicate well location X.

ADDITIONAL INFORMATION

If more than one screen, show locations of each on sketch.