

CODED

MARSHALL

C 3

12-18-68

MISSISSIPPI
 BOARD OF WATER COMMISSIONERS
 416 North State Street
 Jackson, Mississippi 39201

CODED

WATER WELL DRILLERS LOG

Dec 18 1968
date well completed

Bempas Well Co
firm name

Marshall
county well located

LANDOWNER:

John Shelton
Lower P.H.
(mailing address)

description of formations encountered

Clay
5m

from

to

0 20
20 1100

WELL LOCATION:

sec 27 T 1 N R 2 E
S W
2 miles North Sharp Store
(distance) (direction) (nearest town)

WELL PURPOSE:

(home, irrigation, municipal, industrial)

WELL COMPLETION DATA:

- (1) diameter (inches) 4
- (2) total depth (feet) 160
- (3) static water level (feet) 100 below top of ground
- (4) casing PVC 152 (material) (depth)
4 (size) if telescope see back.
- (5) screen 8' 152 (length) (depth to top)
4 (size) gravel well (material)
- (6) pump 3/8 10 (HP) (yield gpm)
Elect (type power)

(7) electric log (yes or no)

(organization running log)

(8) how well bottom plugged 2' gravel plug

DRILLERS REMARKS:

CODED


CODED

DEC 17 1968

MISS. DEP. OF
WATER RESOURCES
STATE BUREAU

If well telescopes please sketch and show depths.

GROUND LEVEL

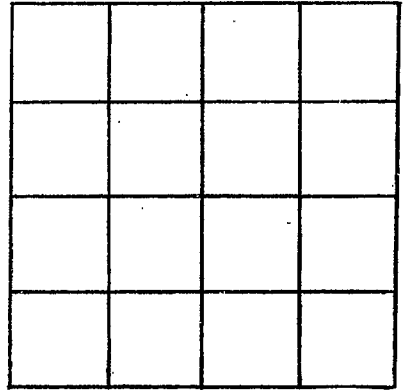

SECTION _____

Please indicate well location X.

ADDITIONAL INFORMATION

If more than one screen, show locations of each on sketch.