

Marshall  
 C5  
 8-27-69

MISSISSIPPI  
 BOARD OF WATER COMMISSIONERS  
 416 North State Street  
 Jackson, Mississippi 39201

WATER WELL DRILLERS LOG



Aug. 27 1969 R. L. Carpenter Marshall  
 date well completed firm name county well located

LANDOWNER: Jimmie Yeager  
 Slayden, Miss.

(mailing address)

WELL LOCATION:

sec. 32 T 1 N R 2 E  
 1/2 miles north of Slayden  
 (distance) (direction) (nearest town)


WELL PURPOSE: none  
 (home, irrigation, municipal, industrial)

WELL COMPLETION DATA:

- (1) diameter (inches) 4 in.
- (2) total depth (feet) 220
- (3) static water level (feet) 170 below top of ground.
- (4) casing Plastic, 214 ft (material) (depth)  
 (size) if telescope see back.
- (5) screen 6 ft, 214 ft (length) (depth to top)  
 4 in. Plastic & sand (size) (material)
- (6) pump 3/4 (HP) 10 (yield gpm)  
 2 hp (type power)
- (7) electric log no (yes or no)

(organization running log) Plastic Plug  
 (8) how well bottom plugged

description of formations encountered	from	to
Surface Soil	0	18
Coarse Red Sand	18	39
White Coarse Sand	39	90
White Clay	90	101
White Fine Sand	101	142
White Coarse Sand	142	220

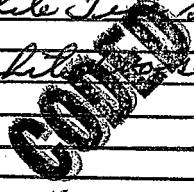

MAR 10 1970

MISS. BD. OF  
 WATER COMM.


DRILLERS REMARKS:

If well telescopes please sketch and show depths.

GROUND LEVEL

R2W

T15

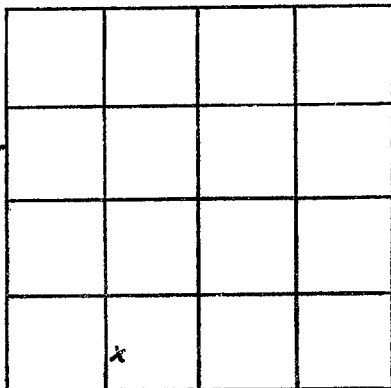

SECTION 32

Please indicate well location X.

ADDITIONAL INFORMATION

If more than one screen,  
show locations of each on sketch.