

MARSHALL
 C 11
 10-2-70

MISSISSIPPI
 BOARD OF WATER COMMISSIONERS
 416 North State Street
 Jackson, Mississippi 39201

CODED

WATER WELL DRILLERS LOG

Oct 2 1970 R. L. Carpenter Marshall
 date well completed firm name county well located

LANDOWNER: Louis Sides
Loma, Miss
RFD
 (mailing address)

description of formations encountered

from to

Surface Soil	0	15
med. Red Soil	15	35
Med white Soil	35	60
White Clay	60	71
Med white Soil	71	110
Coarse white Soil	110	130

WELL LOCATION:

sec. 26 T 1 N R 2 E
3 1/2 miles South of Sharon
 (distance) (direction) (nearest town)

WELL PURPOSE: None
 (home, irrigation, municipal, industrial)

WELL COMPLETION DATA:

- (1) diameter (inches) 4 in.
- (2) total depth (feet) 130
- (3) static water level (feet) 160 below above top of ground.
- (4) casing Plastic, 124 ft.
 (material) (depth)

(size) if telescope see back.

- (5) screen 6 ft., 124 ft.
 (length) (depth to top)
4 in. Plaster Sand
 (size) (material)
- (6) pump 3/4, 10
 (HP) (yield gpm)
Elec.
 (type power)

(7) electric log no
 (yes or no)

(organization running log)

(8) how well bottom plugged Plastic Plug

CODED


DEC 7 1970

DRILLERS REMARKS:

MISS. BD. OF
 WATER CD.

If well telescopes please sketch and show depths.

GROUND LEVEL

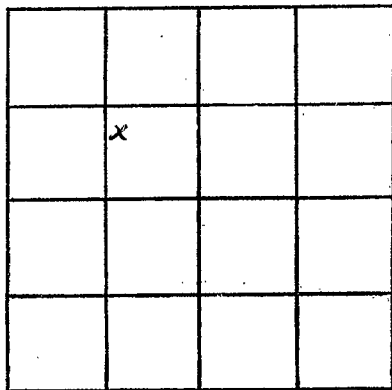

SECTION 26

Please indicate well location X.

ADDITIONAL INFORMATION

If more than one screen, show locations of each on sketch.