

MARSHALL
 C 12
 10-7-70

MISSISSIPPI
 BOARD OF WATER COMMISSIONERS
 416 North State Street
 Jackson, Mississippi 39201

CODED

WATER WELL DRILLERS LOG

Oct 7 1970 R. L. Carpenter Marshall
 date well completed firm name county well located

LANDOWNER: Tommie Jones
 Moscow, Tenn.
 RFD
 (mailing address)

description of formations encountered	from	to
Surface Soil	0	12
Coarse Red Sand	12	39
Coarse white sand	39	88
Med white sand	88	120
Coarse white sand	120	159
Sand Rock	159	160
Blue mud	160	260
Med white sand	260	285
Coarse white sand	285	315

WELL LOCATION:
 sec. 31 T 1 N R 2 E
 1/2 miles west of Snyder
 (distance) (direction) (nearest town)

WELL PURPOSE: Home
 (home, irrigation, municipal, industrial)

- WELL COMPLETION DATA:
- (1) diameter (inches) 4 in.
 - (2) total depth (feet) 315
 - (3) static water level (feet) 150 below top of ground.
 - (4) casing Plastic, 303 ft. (material) (depth)
 - (size) If telescope see back.
 - (5) screen 12, 383 ft. (length) (depth to top)
 - 4 in. Plastic & Trawl (size) (material)
 - (6) pump 3/4, 10 (HP) (yield gpm)
 - Elec. (type power)
 - (7) electric log No (yes or no)

(organization running log)
 Plastic Pkg
 (8) how well bottom plugged

DRILLERS REMARKS:


CODED

DEC 7 1970

MISS. BD. OF WATER COM.

If well telescopes please sketch and show depths.

GROUND LEVEL

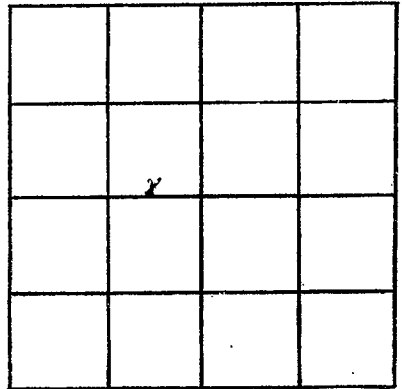

SECTION 31

Please indicate well location X.

ADDITIONAL INFORMATION

If more than one screen, show locations of each on sketch.