

MARSHALL

C 13

10-30-70

MISSISSIPPI BOARD OF WATER COMMISSIONERS 416 North State Street Jackson, Mississippi 39201

CODED

WATER WELL DRILLERS LOG

Oct. 30 1970 date well completed

R. L. Carpenter firm name

Marshall county well located

LANDOWNER: Slayden School

Slayden, Miss.

(mailing address)

WELL LOCATION:

sec. 32 T-1 N R-2 E in Slayden miles of (distance) (direction) (nearest town)

WELL PURPOSE: School (home, irrigation, municipal, industrial)

WELL COMPLETION DATA:

- (1) diameter (inches) 11 in
(2) total depth (feet) 245
(3) static water level (feet) 183 below top of ground.
(4) casing Plastic 233 ft. (material) (depth)
(5) screen 12 ft. 233 ft. (length) (depth to top)
(6) pump 1 1/2 HP 20 (yield gpm)
(7) electric log no (yes or no)

(organization running log)

(8) how well bottom plugged Plastic Clay

DRILLERS REMARKS:

description of formations encountered

from to

Table with 3 columns: description of formations encountered, from, to. Rows include: Surface soil (0-20), Med. Red sand (20-33), Red Coarse sand (33-60), White Coarse sand (60-115), White Fine sand (115-156), White clay (156-175), med white sand (175-205), White coarse sand (205-245).


CODED

DEC. 7 1970

MISS. DE. OF WATER COM.

If well telescopes please sketch and show depths.

GROUND LEVEL

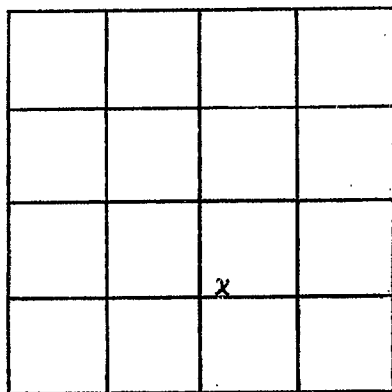

SECTION 32

Please indicate well location X.

ADDITIONAL INFORMATION

If more than one screen, show locations of each on sketch.