

MARSHALL
C 14
11-10-70

MISSISSIPPI
 BOARD OF WATER COMMISSIONERS
 416 North State Street
 Jackson, Mississippi 39201

CODED

WATER WELL DRILLERS LOG

Nov 10 1970 R. L. Carpenter Marshall
 date well completed firm name county well located

LANDOWNER: Hiram Crutcher

Moscow, Tenn.

RFD
 (mailing address)

WELL LOCATION:

sec. 21 T. 1 N. R. 2 E.
 (S) (W)
2 miles Northwest of Slip
 (distance) (direction) (nearest town)

WELL PURPOSE: Home
 (home, irrigation, municipal, industrial)

WELL COMPLETION DATA:

- (1) diameter (inches) 4 in.
- (2) total depth (feet) 154
- (3) static water level (feet) 120 below above top of ground.
- (4) casing Plastic, 148 ft.
 (material) (depth)
 (size) if telescope see back.
- (5) screen 6 ft., 148 ft.
 (length) (depth to top)
4 in., Plastic & Steel
 (size) (material)
- (6) pump 3/4 10
 (HP) (yield gpm)
Elec
 (type power)
- (7) electric log No
 (yes or no)

(organization running log)

(8) how well bottom plugged Plastic Plug

description of formations encountered

from to

<u>Surface Soil</u>	<u>0</u>	<u>13</u>
<u>White, Coarse Sand</u>	<u>13</u>	<u>65</u>
<u>Med white sand</u>	<u>65</u>	<u>83</u>
<u>white clay</u>	<u>83</u>	<u>90</u>
<u>Fine white sand</u>	<u>90</u>	<u>110</u>
<u>Coarse white sand</u>	<u>110</u>	<u>154</u>

CODED


DEC 7 1970

DRILLERS REMARKS:

MISS. BD. OF
 WATER COMM.

If well telescopes please sketch and show depths.

GROUND LEVEL

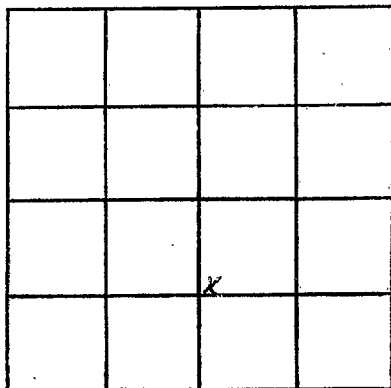

SECTION 21

Please indicate well location X.

ADDITIONAL INFORMATION

If more than one screen,
show locations of each on sketch.