

MARSHALL
C15
11-9-70

MISSISSIPPI
 BOARD OF WATER COMMISSIONERS
 416 North State Street
 Jackson, Mississippi 39201

CODED

WATER WELL DRILLERS LOG

date well completed 11-9 19 70 Bumpus Well Co. Marshall
 (signature) Walter R. ... county well located

LANDOWNER:

H-R. Allen
Moscow, Rt 1
 (mailing address)

description of formations encountered

from to

clay	0	20
sand	20	130
clay	130	160
sand	160	215

WELL LOCATION:

sec. 20 T 1 N R. 2 E
5 miles North of Glyden
 (distance) (direction) (nearest town)

WELL PURPOSE: Drinking
 (home, irrigation, municipal, industrial)

WELL COMPLETION DATA:

- (1) diameter (inches) 4"
- (2) total depth (feet) 215
- (3) static water level (feet) 125 below top of ground.
- (4) casing PVC 215
 (material) (depth)
 (size) If telescope see back.
- (5) screen 1/4" 209
 (length) (depth to top)
4" gravel wall
 (size) (material)
- (6) pump 3/4" 10
 (HP) (yield gpm)
 (type power)
- (7) electric log elect.
 (yes or no)
 (organization running log)

CODED

(8) how well bottom plugged 4" Cop.


DRILLERS REMARKS:

JAN 7 - 1971

MISS. BD. OF
 WATER CONTROL

If well telescopes please sketch and show depths.

GROUND LEVEL

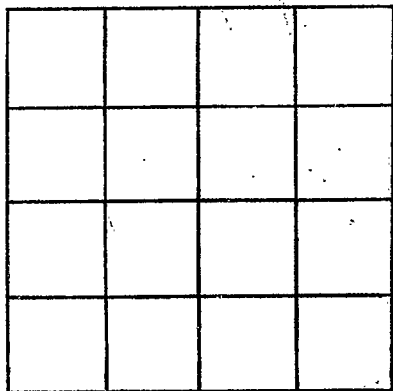

SECTION _____

Please indicate well location X.

ADDITIONAL INFORMATION

If more than one screen, show locations of each on sketch.