

**MARSHALL**  
 C 16  
 3-12-71

MISSISSIPPI  
 BOARD OF WATER COMMISSIONERS  
 416 North State Street  
 Jackson, Mississippi 39201

**CODED**

WATER WELL DRILLERS LOG

March 12 1971 R.L. Carpenter Marshall  
 date well completed firm name county well located

LANDOWNER: Casell Hank

Lamar, RFD

Miss.

(mailing address)

description of formations encountered

from to

Surface Soil	0	12
Med. Red Sand	12	37
White Coarse Sand	37	75
White Clay	75	83
White Coarse Sand	83	125
White Clay	125	160
White Fine Sand & Clay	160	200
White Coarse Sand	200	230

WELL LOCATION:

Sec. 32 T-1 N R-2 E  
 1/2 miles East of Slayden  
 (distance) (direction) (nearest town)

WELL PURPOSE: Home  
 (home, irrigation, municipal, industrial)

WELL COMPLETION DATA:

- (1) diameter (inches) 4
- (2) total depth (feet) 230
- (3) static water level (feet) 183 below top of ground
- (4) casing Plate, 224 ft.  
 (material) (depth)  
 (size) if telescope see back.
- (5) screen 6 ft., 224 ft.  
 (length) (depth to top)  
4 in. Plastic Screen  
 (size) (material)
- (6) pump 3/4 10  
 (HP) (yield gpm)  
Elec.  
 (type power)
- (7) electric log No  
 (yes or no)

(organization running log)  
Plastic Pkg

(8) how well bottom plugged

DRILLERS REMARKS:


**CODED**

MAY 3 1971

MISS. Bd. OF WATER COMMISSIONERS

If well telescopes please sketch and show depths.

GROUND LEVEL

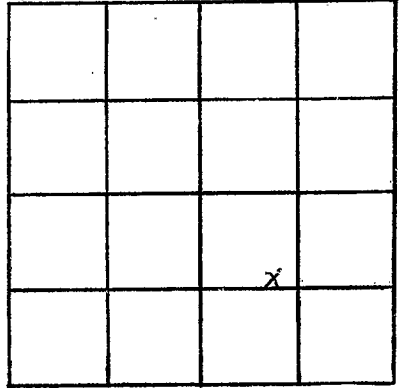

SECTION 32

Please indicate well location X.

ADDITIONAL INFORMATION

If more than one screen,  
show locations of each on sketch.