

MARSHALL
C-17
6-8-71

MISSISSIPPI
 BOARD OF WATER COMMISSIONERS
 416 North State Street
 Jackson, Mississippi 39201

CODED

WATER WELL DRILLERS LOG

6-8 1971 Robert W. Wilson Marshall
 date well completed firm name county well located

LANDOWNER: Theodore Rapp
Lamar
Miss.
 (mailing address)

WELL LOCATION:
 sec. 35 T 1 N R 2 E
 (S) (W)
 miles of
 (distance) (direction) (nearest town)

WELL PURPOSE:
 (home, irrigation, municipal, industrial)

WELL COMPLETION DATA:
 (1) diameter (inches) 4
 (2) total depth (feet) 134
 (3) static water level (feet) 100 below above top of ground.
 (4) casing Plastic
 (material) (depth)
4 if telescope see back.
 (size)
 (5) screen 4 130
 (length) (depth to top)
4 Armed Pearls
 (size) (material)
 (6) pump 3/4 10
 (HP) (yield gpm)
Electric
 (type power)
 (7) electric log ✓
 (yes or no)
 (organization running log)

(8) how well bottom plugged 4"
Plastic Cap

description of formations encountered	from	to
Red Clay Red Sand	0	20
White Clay Red Sand	20	40
White Clay Red Sand	40	60
Red Sand	60	80
Red Sand White Clay	80	100
White Sand Red Sand	100	120
White Sand	120	134

CODED


SEP 7 1971

MISS. BD. OF
 WATER COM.

DRILLERS REMARKS:

If well telescopes please sketch and show depths.

GROUND LEVEL

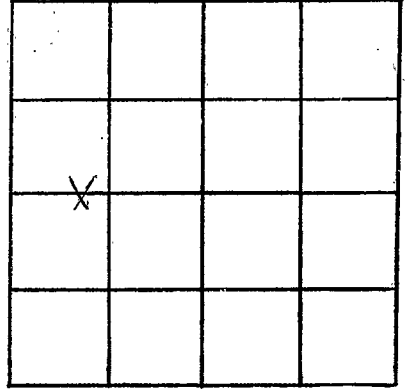

SECTION 35

Please indicate well location X.

ADDITIONAL INFORMATION

If more than one screen, show locations of each on sketch.