

C18

WATER WELL DRILLERS LOG

CODED

7-66

Date: July 6, 1966, Driller: Larry Carpenter County Marshall
(Name)

(1) Owner of Land: Martin Louis
(Name)
Slayden Miss.
(Address)

(2) Location: 1/4, 1/4, Sec. 31 T15R21E
4 miles E of MT. Pleasant
(distance) (direction) (Nearest Town)

(3) Topography: Hilly
(Hilly) (Flat) (Level)

(4) Purpose of Well: Resident
(Domestic Irrigation-
Municipal, Industrial, Other)

Description & Color of Materials Sand, Clay, Red Clay, Shell, etc.	Thick- ness Feet	Depth Feet
Surface Soil to	15	15
medium Red sand from 15 to 18 ft.	3	18
White Clay from 18 to 27 ft.	9	27
white coarse sand from 27 ft. to 94 ft.	67	94

Information upon completion of well:

(1) Diameter 4 inches.

(2) Total Depth 170 feet.

(3) Water Level 134 feet below top of ground.

(4) Cased to 163, Size 4 in.

(5) Screen: Size 4 in., Length 7 ft.


(6) Were any formations sealed against pollution?
_____ yes, X no.

white coarse and fine sand mixed from 94 to 124 ft.	30	124
white medium sand from 124 to 155 ft.	31	155
white coarse sand from 155 to 170 ft.	15	170

If YES depth of formation _____

Why _____

Drillers Remarks: _____

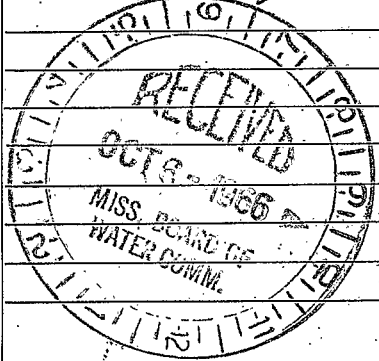

(Use Back Side)

Well No.

1- Boot of We Miss
Marshall
Benton
Dacota
Tajpita