

Marshall  
C19  
10-66

MISSISSIPPI  
BOARD OF WATER COMMISSIONERS  
416 North State Street  
Jackson, Mississippi 39201

**CODED**

WATER WELL DRILLERS LOG

10-10-1966 Robert W. Wilson Marshall  
date well completed firm name county well located

LANDOWNER: J. H. Hogan  
Sladen  
Miss.  
(mailing address)


description of formations encountered	from	to
Red clay	0	10
Red clay + sand	10	20
white clay	20	50
White clay & sand	50	100

WELL LOCATION:  
sec. 20 T. 1 N. R. 2 E.  
3 miles N of Sladen  
(distance) (direction) (nearest town)

WELL PURPOSE: home  
(home, irrigation, municipal, industrial)

- WELL COMPLETION DATA:
- (1) diameter (inches) 4"
  - (2) total depth (feet) 100'
  - (3) static water level (feet) 65' below top of ground.
  - (4) casing Plastic, 96' (material), (depth)  
4" (size) if telescope see back.
  - (5) screen 4' (length), 96' (depth to top)  
4" (size), Gal. Pac. Slotted Pipe (material)
  - (6) pump 1/2 (HP), (yield gpm)  
Elet. (type power)
  - (7) electric log No (yes or no)  
(organization running log)
  - (8) how well bottom plugged 4" plastic cap

**CODED**

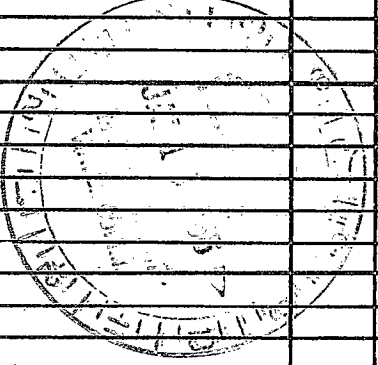

DRILLERS REMARKS:

If well telescopes please sketch and show depths.

GROUND LEVEL


SECTION \_\_\_\_\_

Please indicate well location X.

ADDITIONAL INFORMATION

If more than one screen, show locations of each on sketch.