

Marshall
C21
 7-67

MISSISSIPPI
 BOARD OF WATER COMMISSIONERS
 416 North State Street
 Jackson, Mississippi 39201

WATER WELL DRILLERS LOG

CODED
Marshall

7-26 1967 *Robert Rubinson*
 date well completed firm name county well located

LANDOWNER: *Joe Boyd Burnett*
Mosscom St.
Miss.
 (mailing address)


description of formations encountered	from	to
<i>Red Clay</i>	<i>0</i>	<i>10</i>
<i>Red Sand</i>	<i>10</i>	<i>40</i>
<i>white clay white sand</i>	<i>40</i>	<i>50</i>
<i>white sand</i>	<i>50</i>	<i>110</i>

WELL LOCATION:
 sec. 17 T. 1 N. R. 2 E.
 (S) (W)
Exact location unknown
 (distance) (direction) (nearest town)

WELL PURPOSE:
 (home, irrigation, municipal, industrial)

- WELL COMPLETION DATA:
- (1) diameter (inches) 4"
 - (2) total depth (feet) 110'
 - (3) static water level (feet) 60' below top of ground.
 - (4) casing plastic, 106' (material) (depth)
4" (size) if telescope see back.
 - (5) screen 4', 106' (length) (depth to top)
4" (size) Gravel pack (material)
 - (6) pump 1/2, 10 (HP) (yield gpm)
elect. (type power)
 - (7) electric log (yes or no)
(organization running log)
 - (8) how well bottom plugged 4"
plastic cap


CODED

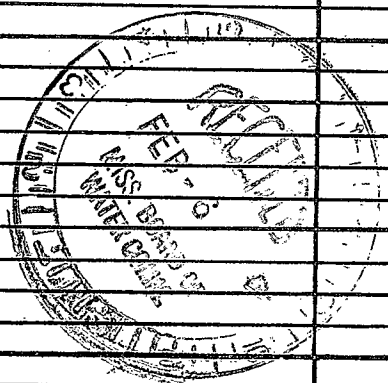

DRILLERS REMARKS:

If well telescopes please sketch and show depths.

GROUND LEVEL

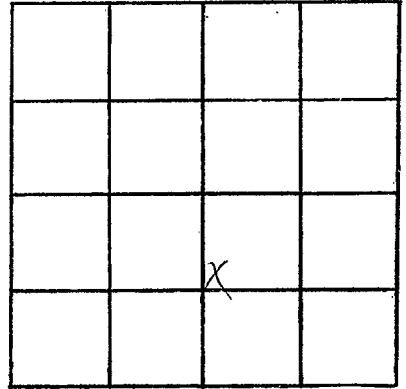

SECTION 17

Please indicate well location X.

ADDITIONAL INFORMATION

If more than one screen,
show locations of each on sketch.