

MARSHALL
C22
9-67

MISSISSIPPI
BOARD OF WATER COMMISSIONERS
416 North State Street
Jackson, Mississippi 39201

CODED

WATER WELL DRILLERS LOG

Sept. 29, 1967 19
date well completed

R. L. Carpenter
firm name

Marshall
county well located

LANDOWNER: Willie Skelton

description of formations
encountered

from

to

Lamar, Miss.

Surface soil

0 15

(mailing address)

Med. Red sand

15 32

WELL LOCATION:

sec 32 T 1 N R 2 E

well located in slaydon, miss

(distance) _____ miles (direction) _____ of (nearest town) _____

White coarse sand

15 98

White clay

98 103

WELL PURPOSE: Home
(home, irrigation, municipal, industrial)

white coarse sand

103 200

WELL COMPLETION DATA:

- (1) diameter (inches) 4
(2) total depth (feet) 200
(3) static water level (feet) 170 below above top of ground.
(4) casing Plastic, 194,
(material) (depth)
(size) if telescope see back.

- (5) screen 6 feet, 194
(length) (depth to top)
4 in., Plastic & gravel
(size) (material)
(6) pump 3/4, 12
(HP) (yield gpm)
Elec.
(type power)


- (7) electric log no
(yes or no)

(organization running log)

- (8) how well bottom plugged Plastic Plug

DRILLERS REMARKS:

CODED

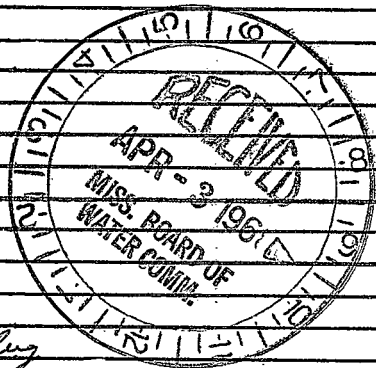


If well telescopes please sketch and show depths.

GROUND LEVEL

R 2 W

T15

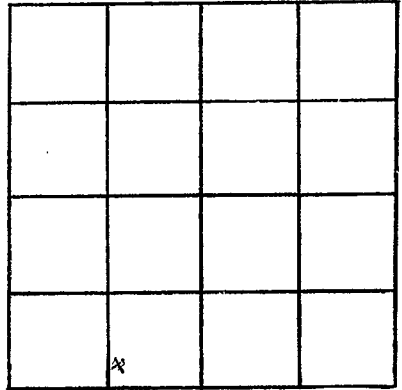

SECTION 32

Please indicate well location X.

ADDITIONAL INFORMATION

If more than one screen, show locations of each on sketch.

COPIED