

**MISSISSIPPI  
BOARD OF WATER COMMISSIONERS**  
416 North State Street  
Jackson, Mississippi 39201

**WATER WELL DRILLERS LOG**

**CODED**

*Marshall*  
*23*  
*9-67*

*9-21 1967*      *Robert Wilson*

date well completed      firm name      county well located

LANDOWNER: *John K. Wilburn*  
*Moscom Rd*  
*Miss.*  
(mailing address)

description of formations encountered	from	to
<i>Red clay</i>	<i>0</i>	<i>10</i>
<i>Red sand</i>	<i>10</i>	<i>30</i>
<i>Red sand white clay</i>	<i>30</i>	<i>40</i>
<i>White clay white sand</i>	<i>40</i>	<i>50</i>
<i>White sand white clay</i>	<i>50</i>	<i>90</i>
<i>White clay white sand</i>	<i>90</i>	<i>100</i>
<i>White sand white clay</i>	<i>100</i>	<i>110</i>
<i>White sand</i>	<i>110</i>	<i>130</i>

WELL LOCATION:  
sec *16* T *1* N R *2* E  
*(S)*      *(W)*  
*Exact location unknown*  
miles (distance) of (direction) of (nearest town)  
*3/4*      *NW*      *Earlsboro*


WELL PURPOSE:  
(home, irrigation, municipal, industrial)

- WELL COMPLETION DATA:
- (1) diameter (inches) *4"*
  - (2) total depth (feet) *130"*
  - (3) static water level (feet) *40"* below above top of ground.
  - (4) casing *Plastic*, *126"*  
(material) (depth)  
*4"* if telescope see back.  
(size)
  - (5) screen *4"*, *126"*  
(length) (depth to top)  
*4"*, *Gravel pack*  
(size) (material)
  - (6) pump *1/2*, *10*  
(HP) (yield gpm)  
*Elect.*  
(type power)

**CODED**


- (7) electric log *(yes or no)*  
*(organization running log)*
- (8) how well bottom plugged *4"*  
*Plastic cap*

DRILLERS REMARKS:

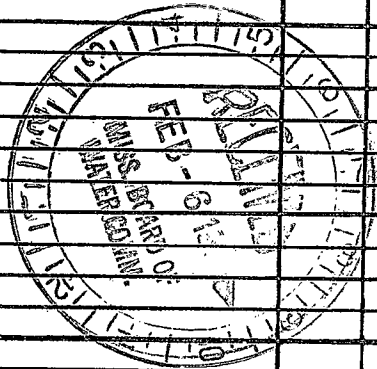

If well telescopes please sketch and show depths.

GROUND LEVEL

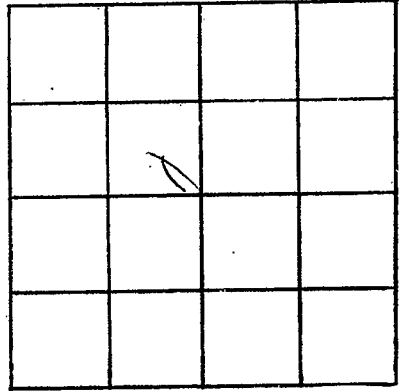

SECTION 16

Please indicate well location X.

ADDITIONAL INFORMATION

**CODED**

**CODED**

If more than one screen, show locations of each on sketch.