

MARSHALL
C 26
11-20-72

MISSISSIPPI
BOARD OF WATER COMMISSIONERS
416 North State Street
Jackson, Mississippi 39201

CODED

WATER WELL DRILLERS LOG

Nov. 20 1972 R.L. Carpenter Marshall
date well completed firm name county well located

LANDOWNER: Sharp, The
Lamar, Miss. Rt. 1

(mailing address)

WELL LOCATION:

sec. 35 T 1 N R 2 E
3 miles East of Slayers
(distance) (direction) (nearest town)

WELL PURPOSE: Home + Waterwell
(home, irrigation, municipal, industrial)

WELL COMPLETION DATA:

- (1) diameter (inches) 4
- (2) total depth (feet) 180
- (3) static water level (feet) 115 ^{below} top of ground.
- (4) casing Plastic, 167 ft.
(material) (depth)
if telescope see back.
(size)
- (5) screen 13 ft., 167 ft.
(length) (depth to top)
4 in., Plastic + Sand
(size) (material)
- (6) pump 1 1/2 20
(HP) (yield gpm)
Eben
(type power)
- (7) electric log No
(yes or no)
(organization running log)
- (8) how well bottom plugged Plastic cap

description of formations encountered

from to

Surface Sand	8	18
med. Red Sand	18	40
med white sand	40	78
white clay	78	91
white coarse sand	91	120
white clay	120	132
med. white sand	132	154
Coarse white sand	154	180


CODED

DRILLERS REMARKS:

NOV 30 1972

If well telescopes please sketch and show depths.

GROUND LEVEL

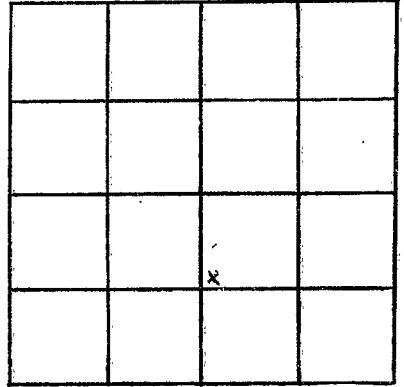

SECTION 35

Please indicate well location X.

ADDITIONAL INFORMATION

If more than one screen, show locations of each on sketch.