

MARSHALL
C 28
3-21-74

MISSISSIPPI
 BOARD OF WATER COMMISSIONERS
 416 North State Street
 Jackson, Mississippi 39201

CODED

WATER WELL DRILLERS LOG

3-21-74 date well completed Shirley Bros. Well Co. firm name Marshall county well located

LANDOWNER:
Walter C. Dentch - Rt 1
Box 26, Samar, Miss.
 (mailing address)

| description of formations encountered | from | to |
|---------------------------------------|------------|------------|
| <u>Red Clay</u> | <u>0</u> | <u>20</u> |
| <u>white clay</u> | <u>20</u> | <u>50</u> |
| <u>white clay + sand</u> | <u>50</u> | <u>65</u> |
| <u>white sand</u> | <u>65</u> | <u>110</u> |
| <u>white clay + sand</u> | <u>110</u> | <u>140</u> |
| <u>white sand</u> | <u>140</u> | <u>170</u> |

WELL LOCATION:
 sec 32 T 1 N R 2 E
1/2 miles E of Slipden
 (distance) (direction) (nearest town)

WELL PURPOSE: Home
 (home, irrigation, municipal, industrial)

WELL COMPLETION DATA:

(1) diameter (inches) 4 1/2

(2) total depth (feet) 170

(3) static water level (feet) 90 below above top of ground.

(4) casing Plastic 170
 (material) (depth)

(size) If telescope see back.

(5) screen 4 1/2 166
 (length) (depth to top)
4 1/2 Gravel
 (size) (material)

(6) pump 3/4 10
 (HP) (yield gpm)
Electric 220
 (type power)

(7) electric log no
 (yes or no)

(organization running log)

(8) how well bottom plugged Cap


CODED

APR 2 1974
 MISS. BD. OF WATER

DRILLERS REMARKS:

If well telescopes please sketch and show depths.

GROUND LEVEL

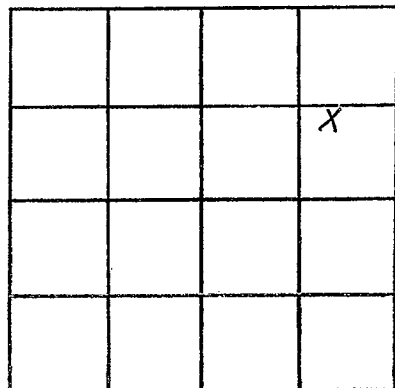

SECTION 32

Please indicate well location X.

ADDITIONAL INFORMATION

If more than one screen, show locations of each on sketch.