

MARSHALL

C 29

6-16-74

MISSISSIPPI
 BOARD OF WATER COMMISSIONERS
 416 North State Street
 Jackson, Mississippi 39201

CODED

WATER WELL DRILLERS LOG

6-16-1974
date well completed

74 Hicks Blvd. W. W. MARSHALL
firm name

county well located

LANDOWNER: Jimmy

Arwood

(mailing address)

description of formations encountered

from

to

Red Clay

0


15

White Sand

15

205

WELL LOCATION:

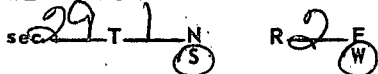

(distance) miles (direction) of (nearest town)

WELL PURPOSE:

(home, irrigation, municipal, industrial)

WELL COMPLETION DATA:

- (1) diameter (inches) 4 in
- (2) total depth (feet) 205
- (3) static water level (feet) 145 below top of ground

- (4) casing Plastic, 205 (material) (depth)

(size) if telescope see back.

- (5) screen 4 ft, 201 (length) (depth to top)

4 in, Gravel (size) (material)

- (6) pump 1/2, 10 (HP) (yield gpm)


Electric 220 (type power)

- (7) electric log no (yes or no)

(organization running log)

- (8) how well bottom plugged Cap

CODED

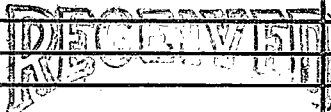

AUG - 2 1974

DRILLERS REMARKS:

MISS. DE. OF WATER COMM.

If well telescopes please sketch and show depths.

GROUND LEVEL

X			

SECTION 29

Please indicate well location X.

ADDITIONAL INFORMATION

If more than one screen,
show locations of each on sketch.