

MARSHALL
C 30
7-13-74

MISSISSIPPI
BOARD OF WATER COMMISSIONERS
416 North State Street
Jackson, Mississippi 39204

CODED

WATER WELL DRILLERS LOG

July 13, 1974 R. L. Carpenter Marshall
date well completed firm name county well located

LANDOWNER: Stanley Hurdle
Marion, Tenn
RFD
(mailing address)


description of formations encountered	from	to
surface soil	0	20
med. red sand	20	35
red clay	35	47
Fine white sand	47	83
med. white sand	83	120
white clay	120	170
white coarse sand	170	195

WELL LOCATION:
sec 19 T-1 N R-2 E
2 1/2 miles North of Stacy
(distance) (direction) (nearest town)

WELL PURPOSE: Home
(home, irrigation, municipal, industrial)


- WELL COMPLETION DATA:
- (1) diameter (inches) 4
 - (2) total depth (feet) 195
 - (3) static water level (feet) 128 below/above top of ground.
 - (4) casing Plastic, 189 ft.
(material) (depth)
(size) if telescope see back.
 - (5) screen 6 ft., 189 ft.
(length) (depth to top)
4 in., Plastic & gravel
(size) (material)
 - (6) pump 3/4, 16
(HP) (yield gpm)
Ebc.
(type power)
 - (7) electric log No
(yes or no)
(organization running log)
 - (8) how well bottom plugged Plastic cap

DRILLERS REMARKS:

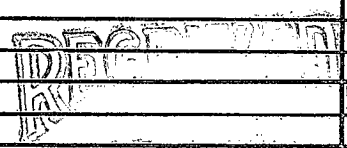

If well telescopes please sketch and show depths.

GROUND LEVEL

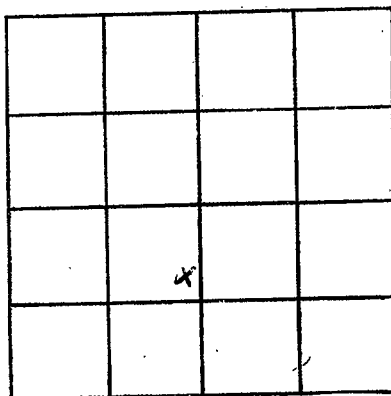

SECTION 19

Please indicate well location X.

ADDITIONAL INFORMATION

If more than one screen, show locations of each on sketch.