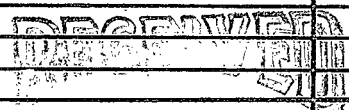


Marshall  
 C 32  
 11-5-74

MISSISSIPPI  
 BOARD OF WATER COMMISSIONERS  
 416 North State Street  
 Jackson, Mississippi 39201


WATER WELL DRILLERS LOG CODED

Nov. 5 1974 R. L. Carpenter Marshall  
 date well completed firm name county well located

LANDOWNER: <u>Slyden Baptist</u>	description of formations encountered	from	to
<u>Parsonage</u>	<u>Surface Soil</u>	0	15
<u>Slyden, Miss</u> (mailing address)	<u>Red Red Sand</u>	15	30
WELL LOCATION: sec. <u>32</u> T <u>1</u> N R <u>2</u> E 16N	<u>Red coarse sand</u>	30	53
<u>1/4</u> miles <u>West</u> of <u>Slyden</u> (distance) (direction) (nearest town)	<u>White coarse sand</u>	53	110
WELL PURPOSE: <u>Home</u> (home, irrigation, municipal, industrial)	<u>White fine sand &amp; white clay</u>	110	140
WELL COMPLETION DATA:	<u>White CODED sand</u>	140	167
(1) diameter (inches) <u>4</u>			
(2) total depth (feet) <u>167</u>			
(3) static water level (feet) <u>158</u> below top of ground.			
(4) casing <u>Plastic</u> , <u>159'</u> (material) (depth)			
<u>        </u> If telescope see back. (size)			
(5) screen <u>6'</u> , <u>159'</u> (length) (depth to top)			
<u>6 in</u> , <u>Plastic</u> (size) (material)			
(6) pump <u>3/4</u> , <u>10</u> (HP) (yield gpm)			
<u>Elec.</u> (type power)			
(7) electric log <u>No</u> (yes or no)			
<u>        </u> (organization running log)			
(8) how well bottom plugged <u>Plastic cap</u>			
DRILLERS REMARKS:	 JUL 21 1975 MISS. Bd. OF WATER COMMISSIONERS		

If well telescopes please sketch and show depths.

GROUND LEVEL

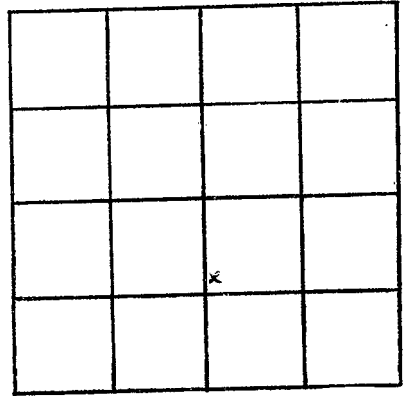

SECTION 32

Please indicate well location X.

ADDITIONAL INFORMATION

If more than one screen,  
show locations of each on sketch.