

MISSISSIPPI DEPARTMENT OF ENVIRONMENTAL QUALITY

Office of Land and Water Resources

P. O. Box 10631
Jackson, MS 39289-0631
WATER WELL DRILLERS LOG

COUNTY WELL LOCATED
Maeshall

WELL NUMBER
C-34

CODED

DATE WELL COMPLETED
6-25-2003

PERMIT NUMBER
MSGW - 15838

NAME OF DRILLING FIRM
Garner Houston Wells

NAME & MAILING ADDRESS OF LANDOWNER
*Chuck Botton
775 Ridge Lake Blvd #400
Memphis, TN - 38120-9464*

Latitude:
Longitude:

WELL LOCATION: SEC TOWNSHIP RANGE
22 N 2 E

DISTANCE DIRECTION NEAREST TOWN
1/2 Miles South of Fayette

OTHER LANDMARK

WELL PURPOSE: Home, Irrigation, Municipal, Industrial, Fish Pond, etc.

PUMP DATA

PUMP TYPE (Circle One):
Submersible Turbine, Jet, Flowing Well,
Other (Describe)

POWER TYPE (Circle One):
Electric, Tractor, Diesel, Gasoline, Butane,
Other (Describe) H/P SD

DESCRIPTION OF FORMATIONS ENCOUNTERED	FROM	TO
<i>Beacon Clay</i>	<i>0</i>	<i>15</i>
<i>Red Soil</i>	<i>15</i>	<i>20</i>
<i>White Clay</i>	<i>20</i>	<i>80</i>
<i>White Soil</i>	<i>80</i>	<i>223</i>

RECEIVED
FEB 10 2003
BY: OLW

WELL DATA

Well Depth <i>223</i>	Casing Diameter (In.) <i>10</i>	Casing Length (Ft.) <i>183</i>
Type of Casing <i>Plastic</i>	Hole Depth <i>223</i>	Depth to Static Water Level <i>80</i>
TYPE OF COMPLETION: (Circle One or More): <u>Gravel Packed</u> , Underreamed, Telescoped, Natural Development, Open Hole, Other (Describe)		
WELL GROUTED TO A DEPTH OF <i>60</i> FEET Type Grout (circle one): Cement, <u>Bentonite</u> , or Mix		

SCREEN DATA

Diameter - Inches <i>10</i>	Length - Feet <i>40</i>	Slot Size - Inches <i>03L</i>
Screen Type <i>Plastic</i>	Depth to Bottom - Feet <i>223</i>	

Top of Lap Pipe or Reduction in Casing
FEET IF TELESCOPED OR MORE THAN ONE SCREEN: USE BACK PAGE


I certify that the well was drilled, constructed and completed in accordance with all applicable Requirements of the Mississippi Department of Environmental Quality and/or the Mississippi Department of Health regulations and state laws.

Garner Houston 0-449
Signature of Licensed Driller and License No.

2-7-2003
Date

If well telescopes please sketch and show depths.

GROUND LEVEL

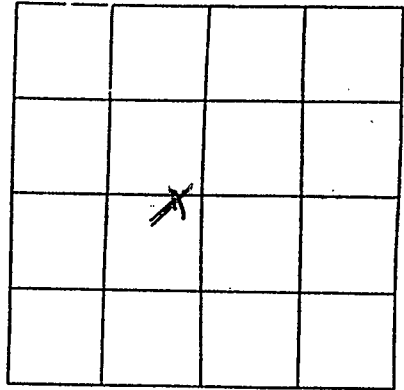

SECTION 22

Please indicate well location X.

Pump Capacity (GPM)	No. of Stages	Setting Depth
1000	2	120 FT.

PUMP TEST

Well yielded 1000 GPM with a drawdown of _____ ft. after _____ hours of pumping

LOG DATA

TYPE OF LOG RUN (Circle One): No Log Run, Electric, Gamma Ray, Density, Sonic, Neutron, Other (Describe) _____

Name of Organization Running Log _____

GEOLOGIC DATA (Office Use Only)

Surface Elev.	Geologic Unit	Unit Thickness	Depth to Top
Subs. SWL	Date	Analysis	Aquifer Test

Driller's Remarks

If more than one screen, show location of each on sketch.