

MARSHALL
C 2000
9-6-75

**MISSISSIPPI
 BOARD OF WATER COMMISSIONERS**
 416 North State Street
 Jackson, Mississippi 39201

15E

WATER WELL DRILLERS LOG

Sept 6 1975 R. L. Carpenter Marshall
 date well completed firm name county well located

LANDOWNER: M. A. Millons
Prosser, Tenn.
RFD
 (mailing address)

WELL LOCATION:
 sec. 33 T 1 N R 2 E
1 miles North of Stacy
 (distance) (direction) (nearest town)

WELL PURPOSE: Home
 (home, irrigation, municipal, industrial)

WELL COMPLETION DATA:

- (1) diameter (inches) 4
- (2) total depth (feet) 160
- (3) static water level (feet) 128 below
 above top of ground.
- (4) casing Plastic, 154ft.
 (material) (depth)
 (size) if telescope see back.
- (5) screen 6 ft., 154ft.
 (length) (depth to top)
Hex. Plastic & Iron
 (size) (material)
- (6) pump 1/2, 8
 (HP) (yield gpm)
Elec.
 (type power)
- (7) electric log No.
 (yes or no)
 (organization running log)
- (8) how well bottom plugged Plastic Cap


description of formations encountered	from	to
<u>Surface Soil</u>	<u>0</u>	<u>15</u>
<u>Trad. & Coarse Red Sand</u>	<u>15</u>	<u>40</u>
<u>Coarse white sand</u>	<u>40</u>	<u>75</u>
<u>White Clay & white fine sand</u>	<u>75</u>	<u>120</u>
<u>White Coarse sand</u>	<u>120</u>	<u>160</u>

DRILLERS REMARKS:

**RECEIVED
 MAR 2 1976**

If well telescopes please sketch and show depths.

GROUND LEVEL

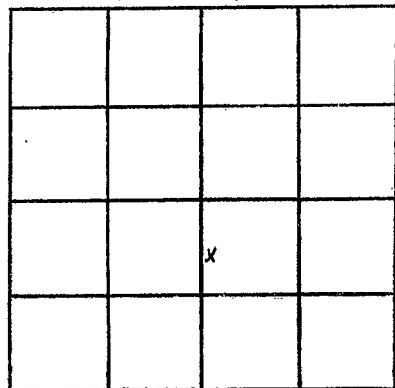

SECTION 33

Please indicate well location X.

ADDITIONAL INFORMATION

If more than one screen,
show locations of each on sketch.