

MARSHALL  
C 2001

MISSISSIPPI DEPARTMENT OF NATURAL RESOURCES  
Bureau of Land and Water Resources  
Southport Mall  
P.O. Box 10631  
Jackson, Mississippi 39209  
WATER WELL DRILLERS LOG

8-6-19 date well completed  
86 Larry Carpenter Well Co firm name  
Marshall county well located


LANDOWNER: Pat Langer  
Langer, Mrs.  
RFD  
(mailing address)

WELL LOCATION:  
sec. 20 T 1 N R 2 E  
S W  
2 1/2 miles north of Sloyden  
(distance) (direction) (nearest town)

WELL PURPOSE: Home  
(home, irrigation, municipal, industrial)

- WELL COMPLETION DATA:
- (1) diameter (inches) 4
  - (2) total depth (feet) 147
  - (3) static water level (feet) 70 below above top of ground.
  - (4) casing PVC, 137' (material) (depth)  
(size) if telescope see back.
  - (5) screen 10' 137' (length) (depth to top)  
4 in. PVC (size) (material)
  - (6) pump 1 HP 70 (HP) (yield gpm)  
Elex (type power)
  - (7) electric log no (yes or no)
  - (organization running log)
  - (8) how well bottom plugged PVC Cap

description of formations encountered	from	to
Surface Soil	0	1.5
red, silty sand	1.5	36
red white sand	36	69
white clay	69	95
white coarse sand	95	147

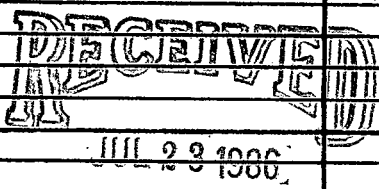


Department of Natural Resources  
Bureau of Land & Water Resources

DRILLERS REMARKS:

If well telescopes please  
sketch and show depths.

GROUND LEVEL

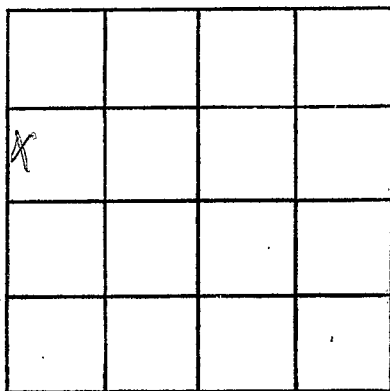

SECTION 20

Please indicate well location X.

ADDITIONAL INFORMATION

If more than one screen,  
show locations of each on sketch.