

MARSHALL
C 2002

MISSISSIPPI DEPARTMENT OF NATURAL RESOURCES
 Bureau of Land and Water Resources
 Southport Mall
 P.O. Box 10631
 Jackson, Mississippi 39209
WATER WELL DRILLERS LOG

10-9 1985 Larry Carpenter Wells Marshall
 date well completed firm name county well located

LANDOWNER: Spence Alexander
Lanox, ms.
RFD
 (mailing address)

description of formations encountered	from	to
<u>Surface Soil</u>	<u>0</u>	<u>22</u>
<u>Med. Red Sand</u>	<u>22</u>	<u>35</u>
<u>White Clay</u>	<u>35</u>	<u>70</u>
<u>Med. White Sand</u>	<u>70</u>	<u>110</u>
<u>White Coarse Sand</u>	<u>110</u>	<u>145</u>

WELL LOCATION:
 sec. 3 T 1 N R 2 E
S W
2 1/2 miles East of Sloydon
 (distance) (direction) (nearest town)

WELL PURPOSE: Home
 (home, irrigation, municipal, industrial)

- WELL COMPLETION DATA:
- diameter (inches) 4
 - total depth (feet) 145
 - static water level (feet) 90 below above top of ground.
 - casing PVC, 135'
 (material) (depth)
 (size) if telescope see back.
 - screen 10', 135'
 (length) (depth to top)
4", PVC
 (size) (material)
 - pump 3/4, 12
 (HP) (yield gpm)
Elco
 (type power)
 - electric log No
 (yes or no)
 (organization running log)
 - how well bottom plugged PVC Cap


RECEIVED
 JUN 23 1986

Department of Natural Resources
 Bureau of Land & Water Resources

DRILLERS REMARKS:

If well telescopes please sketch and show depths.

GROUND LEVEL

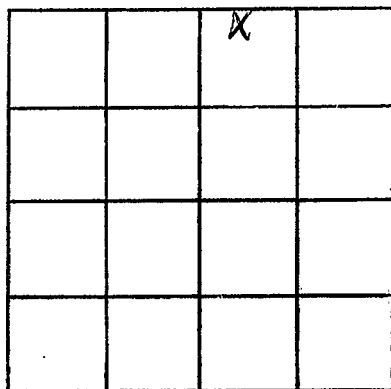

SECTION 3

Please indicate well location X.

ADDITIONAL INFORMATION

If more than one screen, show locations of each on sketch.