

MARSHALL
C
2005
10-1/99

MISSISSIPPI
BOARD OF WATER COMMISSIONERS
416 North State Street
Jackson, Mississippi 39201

WATER WELL DRILLERS LOG

date well completed

firm name

county well located

19 99 ~~De Witt~~ Marshall

LANDOWNER:
Greg Allen
Glenys Mies
(mailing address)

| description of formations encountered | from | to |
|---------------------------------------|------|-----|
| Clay | 0 | 20 |
| Sand | 20 | 190 |

WELL LOCATION:
sec. 32 T 1 N R 2 E
11 miles north of Starbuck
(distance) (direction) (nearest town)

WELL PURPOSE: Drinking
(home, irrigation, municipal, industrial)


- WELL COMPLETION DATA:
- (1) diameter (inches) 4"
 - (2) total depth (feet) 190 ft
 - (3) static water level (feet) 170 below top of ground.
 - (4) casing PVC 190 ft
(material) (depth)
 - (size) If telescope see back.
 - (5) screen 7 ft 193 ft
(length) (depth to top)
 - 4" Brass rod
(size) (material)
 - (6) pump 3/4 10
(HP) (yield gpm)
 - (type power)
 - (7) electric log 5' cut
(yes or no)
 - (organization running log)
 - (8) how well bottom plugged 4' cap

DRILLERS REMARKS:

DEPT. OF NATURAL RESOURCES
BUREAU OF LAND & WATER RESOURCES
OCT 5 1979
RECEIVED
DEPT. OF NATURAL RESOURCES
BUREAU OF LAND & WATER RESOURCES
OCT 5 1979
RECEIVED

If well telescopes please sketch and show depths.

GROUND LEVEL

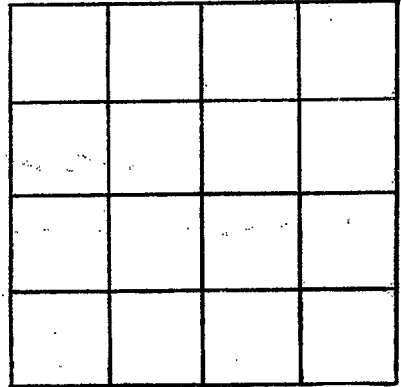

SECTION _____

Please indicate well location X.

ADDITIONAL INFORMATION

If more than one screen, show locations of each on sketch.