

Marshall

10

MISSISSIPPI BOARD OF WATER COMMISSIONERS
416 North State Street
Jackson, Mississippi 39201

C 2006

WATER WELL DRILLERS LOG

8/14/79

Per 14 days well completed

19 Billy R Simpson firm name

MARSHALL county well located

LANDOWNER:	description of formations encountered	from	to
BENNY YAGER			
LAMAN MISS (mailing address)	SAND	10	125
	WHITE CLAY + SAND	125	145
WELL LOCATION:			
sec <u>34</u> T <u>1</u> N R <u>2</u> E <u>5</u> miles <u>E</u> of <u>Dayton</u> (distance) (direction) (nearest town)			
WELL PURPOSE: <u>HOME</u> (home, irrigation, municipal, industrial)			
WELL COMPLETION DATA:			
(1) diameter (inches) <u>4</u>			
(2) total depth (feet) <u>125</u>			
(3) static water level (feet) <u>20</u> below above top of ground.			
(4) casing <u>PVC</u> <u>115</u> (material) (depth)			
(size) If telescope see back.			
(5) screen <u>10</u> <u>105</u> (length) (depth to top)			
<u>4</u> <u>PVC</u> (size) (material)			
(6) pump <u>1/2</u> <u>10</u> (HP) (yield gpm)			
<u>Elec</u> (type power)			
(7) electric log <u>NO</u> (yes or no)			
(organization running log)			
(8) how well bottom plugged <u>PVC</u> <u>TOP</u>			
DRILLERS REMARKS:			


DEPT. OF NATURAL RESOURCES
BUREAU OF LAND & WATER RESOURCES

APR 21 1980

RECEIVED

If well telescopes please sketch and show depths.

GROUND LEVEL

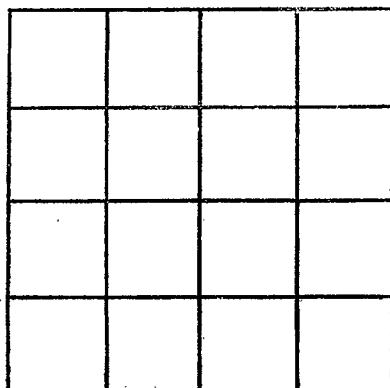

SECTION _____

Please indicate well location X.

ADDITIONAL INFORMATION

If more than one screen,
show locations of each on sketch.