

MARSHALL

C 2007

3-10-78

Mar 10 1978
date well completed

MISSISSIPPI
BOARD OF WATER COMMISSIONERS
416 North State Street
Jackson, Mississippi 39201

WATER WELL DRILLERS LOG

R. L. Carpenter
firm name

Marshall
county well located

LANDOWNER: Benjamin Jones

Moscow, Tenn

RFD

(mailing address)

WELL LOCATION:

sec. 21 T. 1 N. R. 2 E.
3 miles Southwest of Shades
(distance) (direction) (nearest town)

WELL PURPOSE: None
(home, irrigation, municipal, industrial)

WELL COMPLETION DATA:

- (1) diameter (inches) 4
- (2) total depth (feet) 260
- (3) static water level (feet) 142 below
top of ground.
- (4) casing Plastic, 250'
(material) (depth)
(size) if telescope see back.
- (5) screen 18', 250'
(length) (depth to top)
4", Plastic
(size) (material)
- (6) pump 3/4, 10
(HP) (yield gpm)
Edco
(type power)
- (7) electric log No
(yes or no)

(organization running log)

(8) how well bottom plugged pic logs

DRILLERS REMARKS:

description of formations encountered

from

to

Surface Soil

0

18

med. Red Sand

18

45

med. white sand

215

115

white clay

115

160

white fine sand

160

216

white coarse sand

216

260


DEPT. OF NATURAL RESOURCES
BUREAU OF LAND & WATER RESOURCES

JUL 28 1980

RECEIVED

If well telescopes please sketch and show depths.

GROUND LEVEL

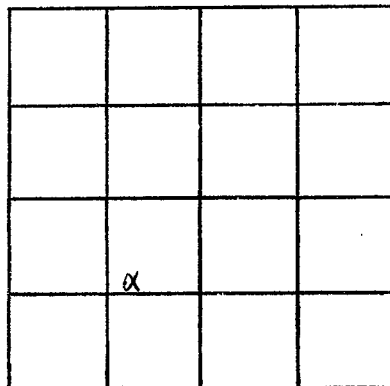

SECTION 21

Please indicate well location X.

ADDITIONAL INFORMATION

If more than one screen,
show locations of each on sketch.