

Marshall  
C 2012

MISSISSIPPI  
BOARD OF WATER COMMISSIONERS  
416 North State Street  
Jackson, Mississippi 39201

WATER WELL DRILLERS LOG

4/26/79  
April 26 1979

R. L. Carpenter

Marshall

date well completed

firm name

county well located

LANDOWNER: Louis J. Briggs  
Mascous, Tenn.  
R. F. D.  
(mailing address)

description of formations encountered	from	to
Suspense Soil	0	20
Med Red Sand	20	45
Cassac. White Sand	45	96
White Clay	96	110
Med White Sand	110	135
White Cassac. Sand	135	172

WELL LOCATION:  
sec. 21 T 1 N R 2 E  
S W  
2 miles N-W of Slaydon  
(distance) (direction) (nearest town)

WELL PURPOSE: Home  
(home, irrigation, municipal, industrial)

WELL COMPLETION DATA:

(1) diameter (inches) 4

(2) total depth (feet) 172

(3) static water level (feet) 150 below above top of ground.

(4) casing Plastic, 16 1/2' (material) (depth)  
(size) if telescope see back.

(5) screen 10' 16 1/2' (length) (depth to top)  
4' Plastic (size) (material)

(6) pump 3/4 12 (HP) (yield gpm)  
Elec (type power)

(7) electric log no (yes or no)  
(organization running log)

(8) how well bottom plugged PVC cap


DRILLERS REMARKS:

DEPT. OF NATURAL RESOURCES  
BUREAU OF LAND & WATER RESOURCES

RECEIVED  
MAY 18 1981

If well telescopes please sketch and show depths.

GROUND LEVEL

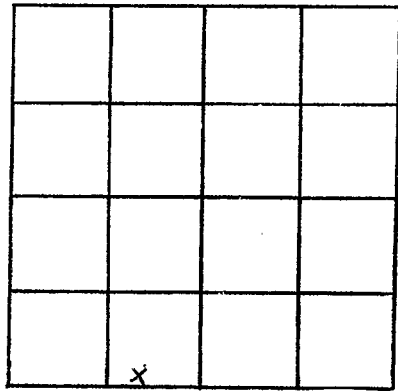

SECTION 21

Please indicate well location X.

ADDITIONAL INFORMATION

Lined area for additional information.

If more than one screen, show locations of each on sketch.