

Marshall
C 2013
4/22/79

MISSISSIPPI
 BOARD OF WATER COMMISSIONERS.
 416 North State Street
 Jackson, Mississippi 39201

WATER WELL DRILLERS LOG

4-22 1979 R. L. Carpenter Marshall
 date well completed firm name county well located

LANDOWNER: R. L. Hunsicker Jr.
Lamar, Miss.
R. F. D.
 (mailing address)

description of formations encountered	from	to
<u>Surface Soil</u>	<u>0</u>	<u>14</u>
<u>Med Red Sand</u>	<u>14</u>	<u>30</u>
<u>Med White Sand</u>	<u>30</u>	<u>65</u>
<u>White Clay</u>	<u>65</u>	<u>70</u>
<u>White fine sand</u>	<u>70</u>	<u>120</u>
<u>White Clay mixed</u>		
<u>White Coarse Sand</u>	<u>120</u>	<u>165</u>

WELL LOCATION:
 sec 8 T 1 N R 2 E
3 1/2 miles East of Shyden
 (distance) (direction) (nearest town)

WELL PURPOSE: Home
 (home, irrigation, municipal, industrial)


- WELL COMPLETION DATA:
- (1) diameter (inches) 4
 - (2) total depth (feet) 165'
 - (3) static water level (feet) 80 below top of ground.
 - (4) casing Plastic, 155'
 (material) (depth)
 (size) If telescope see back.
 - (5) screen 10', 155'
 (length) (depth to top)
4", Plastic
 (size) (material)
 - (6) pump 1/2 9
 (HP) (yield gpm)
Electric
 (type power)
 - (7) electric log no.
 (yes or no)
 (organization running log)
 - (8) how well bottom plugged P.V.C. cap

DRILLERS REMARKS:

DEPT. OF NATURAL RESOURCES
 BUREAU OF LAND & WATER RESOURCES
 RECEIVED
 MAY 18 1981

If well telescopes please sketch and show depths.

GROUND LEVEL

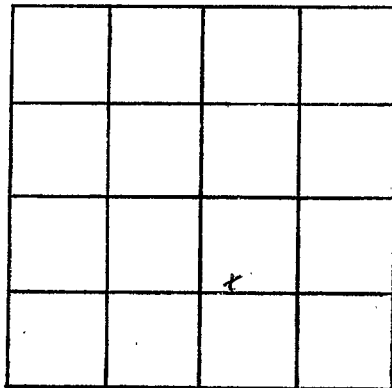

SECTION 35

Please indicate well location X.

ADDITIONAL INFORMATION

If more than one screen,
show locations of each on sketch.