

MISSISSIPPI DEPARTMENT OF NATURAL RESOURCES
Bureau of Land and Water Resources
 Southport Mall
 P.O. Box 10631
 Jackson, Mississippi 39209
WATER WELL DRILLERS LOG

3

Marshall
C 2014
6-30-81


June 30 1981 Dean Kent Simpson Marshall
 date well completed firm name county well located

| LANDOWNER: | description of formations encountered | from | to |
|---|---------------------------------------|-----------|------------|
| <u>Winifred Allen</u> <u>Slogden, Miss.</u> (mailing address) | | | |
| | <u>Sand</u> | <u>20</u> | <u>160</u> |

WELL LOCATION:
 sec. 31 T 1 N R 2 E
 (S) (W)
3 miles West of Slogden
 (distance) (direction) (nearest town)

WELL PURPOSE: Domestic
 (home, irrigation, municipal, industrial)


- WELL COMPLETION DATA:**
- (1) diameter (inches) 4"
 - (2) total depth (feet) 160 feet
 - (3) static water level (feet) 107 below above top of ground.
 - (4) casing PVC, 160 feet
 (material) (depth)
 (size) if telescope see back.
 - (5) screen 24", 153 feet
 (length) (depth to top)
4", Gravel well
 (size) (material)
 - (6) pump 3/4 14
 (HP) (yield gpm)
 (type power)
 - (7) electric log Elect.
 (yes or no)
 (organization running log)
 - (8) how well bottom plugged 4" cof.

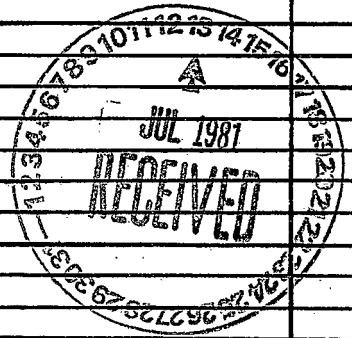

DRILLERS REMARKS:

If well telescopes please
sketch and show depths.

GROUND LEVEL

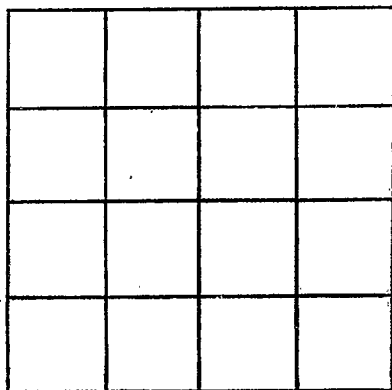

SECTION _____

Please indicate well location X.

ADDITIONAL INFORMATION

If more than one screen,
show locations of each on sketch.