

MISSISSIPPI DEPARTMENT OF NATURAL RESOURCES

Bureau of Land and Water Resources

Southport Mall

P.O. Box 10631

Jackson, Mississippi 39209

WATER WELL DRILLERS LOG

MARSHALL
C 2015
11-10-81

Nov 10 1981 R.L. Carpenter Marshall
 date well completed firm name county well located

LANDOWNER: Beverly Storn
Lamar, Miss.
RFD
 (mailing address)

description of formations encountered	from	to
Surface Soil	0	15
Med Red Sand	15	32
Med White Sand	32	65
White Clay	65	75
White Fine Sand	75	120
White Coarse Sand	120	153

WELL LOCATION:
 sec. 23 T-1 N R-2 E
4 miles NE of Shannon
 (distance) (direction) (nearest town)

WELL PURPOSE: Home
 (home, irrigation, municipal, industrial)

- WELL COMPLETION DATA:
- (1) diameter (inches) 4
 - (2) total depth (feet) 153
 - (3) static water level (feet) 90 below above top of ground.
 - (4) casing PVC, 145'
 (material) (depth)
 (size) If telescope see back.
 - (5) screen 10', 145'
 (length) (depth to top)
4", PVC
 (size) (material)
 - (6) pump 3/4, 12
 (HP) (yield gpm)
Elec
 (type power)
 - (7) electric log no
 (yes or no)
 (organization running log)
 - (8) how well bottom plugged PVC Cap

DEPT. OF NATURAL RESOURCES
 BUREAU OF LAND & WATER RESOURCES


SEP -7 1982

RECEIVED

DRILLERS REMARKS:

If well telescopes please sketch and show depths.

GROUND LEVEL

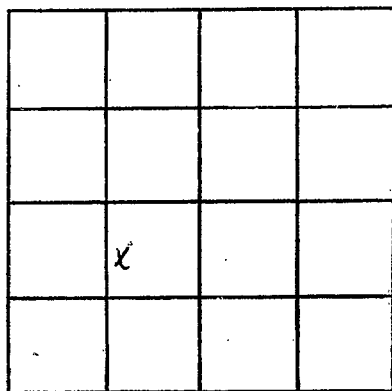

SECTION 23

Please indicate well location X.

ADDITIONAL INFORMATION

If more than one screen,
show locations of each on sketch.