

MISSISSIPPI DEPARTMENT OF NATURAL RESOURCES
 Bureau of Land and Water Resources
 Southport Mall
 P.O. Box 10631
 Jackson, Mississippi 39209
WATER WELL DRILLERS LOG

Marshall
C
2016

1-3 1983 Bornu Earth Well Co. Marshall
 date well completed firm name county well located

LANDOWNER: Christina Steffen
Lamar, Miss.

description of formations encountered

from	to
<u>0</u>	<u>15</u>
<u>15</u>	<u>60</u>
<u>60</u>	<u>80</u>
<u>80</u>	<u>97 1/2</u>

Brown clay
Red sand
White clay
" Sand

(mailing address)

WELL LOCATION:

sec. 36 T-1 N R-2 E
4 1/2 miles E of Stager
 (distance) (direction) (nearest town)

WELL PURPOSE:

(home), irrigation, municipal, industrial

WELL COMPLETION DATA:

- (1) diameter (inches) 4
- (2) total depth (feet) 172
- (3) static water level (feet) 80 below above top of ground.
- (4) casing plastic 162
 (material) (depth)
 (size) If telescope see back.
- (5) screen 10 162
 (length) (depth to top)
4 plastic
 (size) (material)
- (6) pump 3/4 10
 (HP) (yield gpm)
electric
 (type power)
- (7) electric log (yes or no) _____

(organization running log)

(8) how well bottom plugged 1/4 plastic cap

DRILLERS REMARKS:


DEPT. OF NATURAL RESOURCES
 BUREAU OF LAND & WATER RESOURCES

FEB 14 1983

RECEIVED

If well telescopes please sketch and show depths.

GROUND LEVEL

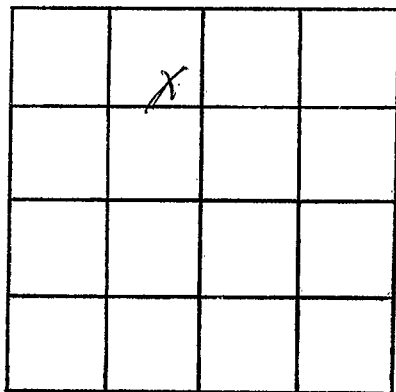

SECTION 36

Please indicate well location X.

ADDITIONAL INFORMATION

If more than one screen,
show locations of each on sketch.