

Marshall
C
2017

MISSISSIPPI DEPARTMENT OF NATURAL RESOURCES
Bureau of Land and Water Resources
Southport Mall
P.O. Box 10631
Jackson, Mississippi 39209
WATER WELL DRILLERS LOG

4-25-84
date well completed

Wilson Well Co. Inc
firm name

Marshall
county well located

LANDOWNER: Herbert Wilburn
Rt 2 Box 229-A
Ashland, Miss.
(mailing address)

WELL LOCATION:
sec 27 T 1 N R 2 E
7 miles NE of Slidell
(distance) (direction) (nearest town)

WELL PURPOSE: Home
(home, irrigation, municipal, industrial)

- WELL COMPLETION DATA:
- (1) diameter (inches) 4
 - (2) total depth (feet) 148
 - (3) static water level (feet) 95 below above top of ground.
 - (4) casing Plastic, 148 (material) (depth)
4 (size) If telescope see back.
 - (5) screen 10 (length) (depth to top)
4 (size) Plastic (material)
 - (6) pump 3/4 (HP) 8 (yield gpm)
Elec. (type power)
 - (7) electric log No (yes or no)
 - (8) how well bottom plugged PVC 4" CAP

description of formations encountered	from to	
Brown Clay - Red Sand	0	15
Red Sand	15	35
White Clay	35	40
White Sand	40	60
White Clay	60	67
White Sand	67	90
White Sand - White Clay	90	98
White Sand	98	105
White Sand - White Clay	105	120
White Sand	120	148

DRILLERS REMARKS:


DEPT. OF NATURAL RESOURCES
BUREAU OF LAND & WATER RESOURCES

MAY 31 1984

RECEIVED

If well telescopes please sketch and show depths.

GROUND LEVEL

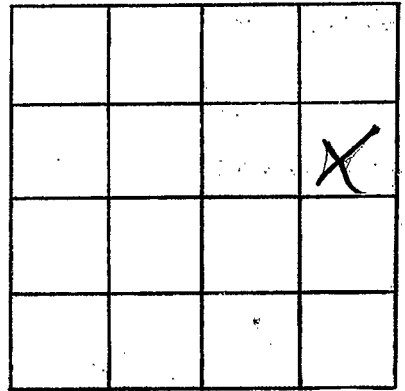

SECTION 27

Please indicate well location X.

ADDITIONAL INFORMATION

If more than one screen,
show locations of each on sketch.