

15E

CODED

MARSHALL
D6
9-25-68

MISSISSIPPI
BOARD OF WATER COMMISSIONERS
416 North State Street
Jackson, Mississippi 39201

CODED

WATER WELL DRILLERS LOG

9-25-68 date well completed
1968 Atkinson & Frost firm name
Marshall county well located

LANDOWNER:
Jimmy Stewart

(mailing address)

description of formations encountered	from	to
red clay	0	5
Red gravel	5	25
white clay	25	30
red sand	30	80
white sand	80	120

WELL LOCATION:
sec. 3 T. 2 N. R. 5 E
1 miles N of *Rayburn*
(distance) (direction) (nearest town)

WELL PURPOSE: *home*
(home, irrigation, municipal, industrial)

WELL COMPLETION DATA:

- (1) diameter (inches) *4"*
- (2) total depth (feet) *120*
- (3) static water level (feet) _____ below/above top of ground.
- (4) casing (material) _____ (depth) _____
(size) _____ if telescope see back.
- (5) screen *5ft* (length) _____ (depth to top) _____
(size) _____ (material) _____
- (6) pump *1/2* (HP) *10* (yield gpm)
Fluc (type power)
- (7) electric log *no* (yes or no)
- (organization running log) _____

CODED


(8) how well bottom plugged *Plugg*
Bar Cross

DRILLERS REMARKS:

JAN 27 1969
MISS. DEP. OF
WATER CONTROL

If well telescopes please sketch and show depths.

GROUND LEVEL

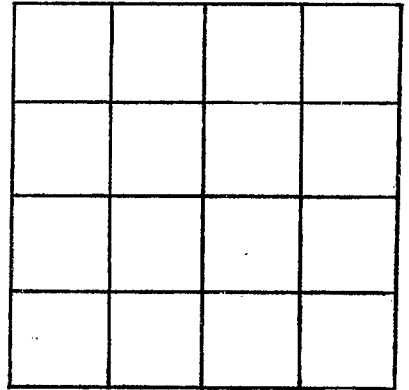

SECTION _____

Please indicate well location X.

ADDITIONAL INFORMATION

If more than one screen, show locations of each on sketch.