

CODING

CODING

Marshall
D T.
2-11-69

MISSISSIPPI
BOARD OF WATER COMMISSIONERS
416 North State Street
Jackson, Mississippi 39201

WATER WELL DRILLERS LOG

2-11 1969 Atkinson & Frost MARSHALL
date well completed firm name county well located

LANDOWNER: Jim Perkins

description of formations encountered from to

Byhalia Miss
(mailing address)

Clay 0 15
Red sand 15 60
white sand 60 145

WELL LOCATION:

sec. 3 T 2 N R 5 E
4 miles N of Byhalia
(distance) (direction) (nearest town)

WELL PURPOSE: none
(home, irrigation, municipal, industrial)

WELL COMPLETION DATA:

- (1) diameter (inches) 4"
- (2) total depth (feet) 145
- (3) static water level (feet) 100 below top of ground.
- (4) casing P.V.C. 135
(material) (depth)
- (size) If telescope see back.
- (5) screen 10 135
(length) (depth to top)
- 4" P.V.C. Redwell
(size) (material)
- (6) pump 3N 10
(HP) (yield gpm)
- Elec
(type power)
- (7) electric log (yes or no)
- (organization running log)
- (8) how well bottom plugged 4" cap


DRILLERS REMARKS:

19 1969

MISSISSIPPI BOARD OF WATER COMMISSIONERS

If well telescopes please sketch and show depths.

GROUND LEVEL

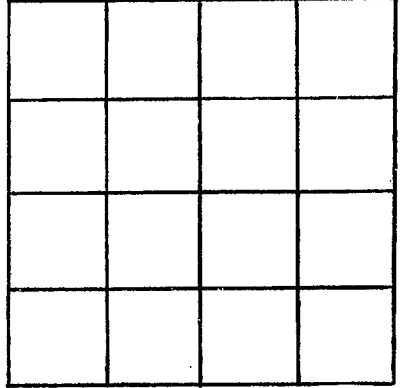

SECTION 3

Please indicate well location X.

ADDITIONAL INFORMATION

If more than one screen, show locations of each on sketch.