

CODED

MISSISSIPPI
BOARD OF WATER COMMISSIONERS
416 North State Street
Jackson, Mississippi 39201

WATER WELL DRILLERS LOG

Marshall
D 11
5-10-69

5-10-1969 date well completed
W. Brown & Wilson firm name
Marshall county well located

LANDOWNER:

Jos. Wallyberg
Memphis Tenn
(mailing address)

description of formations encountered

from to

Clay 0 20
Red Sand 20 50
Yellow Sand/Gravel 50 70
White sand 70 120

WELL LOCATION:

sec. 12 T. 25 N. R. 5 E.
4 miles No. of Memphis
(distance) (direction) (nearest town)

WELL PURPOSE: Home
(home, irrigation, municipal, industrial)

WELL COMPLETION DATA:

- (1) diameter (inches) 4
- (2) total depth (feet) 120
- (3) static water level (feet) 80 below top of ground
- (4) casing Plastic 120 (material) (depth)
- (size) if telescope see back.
- (5) screen 8 112 (length) (depth to top)
- (size) (material) 4 Gravel Pack
- (6) pump 1 HP 16 (HP) (yield gpm)
- (type power) Flat
- (7) electric log (yes or no)

(organization running log)

(8) how well bottom plugged Cap


DRILLERS REMARKS:

3-1969

MISS. BD. OF WATER COMM.

If well telescopes please sketch and show depths.

GROUND LEVEL

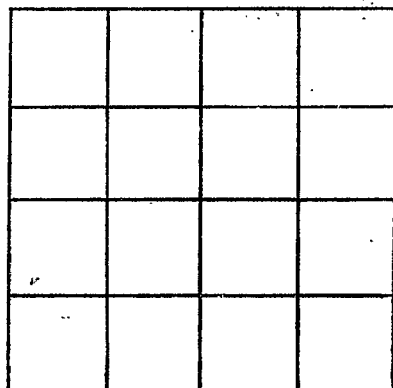

SECTION 12

Please indicate well location X.

ADDITIONAL INFORMATION

If more than one screen, show locations of each on sketch.