

Marshall
D12
8-16-69

MISSISSIPPI
 BOARD OF WATER COMMISSIONERS
 416 North State Street
 Jackson, Mississippi 39201

CODED

WATER WELL DRILLERS LOG

8-16- 1969
 date well completed

Bob Smith
 firm name

Marshall
 county well located

LANDOWNER: Bidlowy
Byhalia Miss
 (mailing address)
 WELL LOCATION:
 sec. 27 T. 2 N. R. 5 E.
3 miles west of Byhalia
 (distance) (direction) (nearest town)

description of formations encountered	from	to
top soil	0	5
red clay	5	10
fine sand & clay	10	80
coarse sand	80	120

WELL PURPOSE: None
 (home, irrigation, municipal, industrial)

- WELL COMPLETION DATA:
- (1) diameter (inches) 4
 - (2) total depth (feet) 120
 - (3) static water level (feet) 25 below top of ground.
 - (4) casing 0 latex 120
 (material) (depth)
 (size) if telescope see back.
 - (5) screen 20 100
 (length) (depth to top)
4 0 latex
 (size) (material)
 - (6) pump 1/2 10
 (HP) (yield gpm)
1 hp
 (type power)
 - (7) electric log no
 (yes or no)

(organization running log)


(8) how well bottom plugged plugged

DRILLERS REMARKS:
good drilling

MISS. BD. OF
 WATER COMMISSIONERS

If well telescopes please sketch and show depths.

GROUND LEVEL

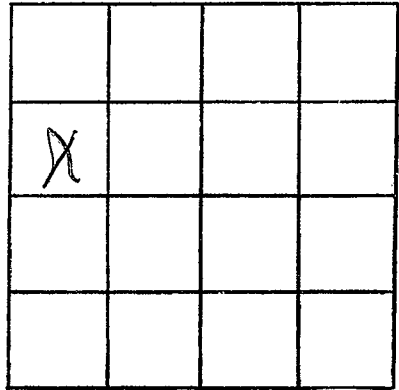

SECTION 27

Please indicate well location X.

ADDITIONAL INFORMATION

If more than one screen, show locations of each on sketch.