

CODED

MISSISSIPPI
BOARD OF WATER COMMISSIONERS
416 North State Street
Jackson, Mississippi 39201

WATER WELL DRILLERS LOG

Marshall
D 13,
10-15-69

10-15 1969 Peterson & Frost Marshall
date well completed firm name county well located

LANDOWNER: John Kennedy
(Barton Mesa)

description of formations encountered	from	to
Bluen	0	10
white sand	10	80
Bluen	80	85
white sand	85	155

Mesa Science Mesa
(mailing address)

WELL LOCATION:
sec. 3 T. 2 N. R. 5 E
1 miles Barton S. East
(distance) (direction) of (nearest town)

WELL PURPOSE:
(home, irrigation, municipal, industrial)

WELL COMPLETION DATA:

- (1) diameter (inches) 4"
- (2) total depth (feet) 155
- (3) static water level (feet) 78 below above top of ground.
- (4) casing 4" 140 (material) (depth)
(size) If telescope see back.
- (5) screen 28 140 (length) (depth to top)
4" x 6" P.V.C. sand (size) (material)
- (6) pump 5 110 (HP) (yield gpm)
Elec. (type power)
- (7) electric log NO (yes or no)
(organization running log)
- (8) how well bottom plugged CAP.


NOV 3 - 1969

DRILLERS REMARKS:

MISS. BD. OF
WATER COM.

If well telescopes please sketch and show depths.

GROUND LEVEL

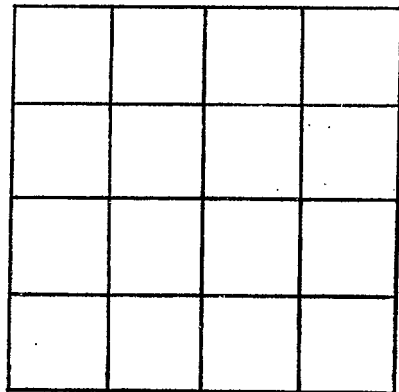

SECTION 3

Please indicate well location X.

ADDITIONAL INFORMATION

If more than one screen, show locations of each on sketch.