

Restrained

Marshall
D14
10-17-69

MISSISSIPPI
BOARD OF WATER COMMISSIONERS
416 North State Street
Jackson, Mississippi 39201

CODED

WATER WELL DRILLERS LOG

October 17th 1969 - W.G. Mason - water well contractor morehead
date well completed firm name county well located

LANDOWNER: Chris T. Ford Sr
69 - 10000 Airport Road Jr
RFD - 1
Byhalia Miss.
(mailing address)

description of formations encountered from to
Very coarse chert to water bearing sand 31 41

WELL LOCATION:
sec 36 T 2 N R 5 E
1 miles East of Byhalia
(distance) (direction) (nearest town)

WELL PURPOSE: Home
(home, irrigation, municipal, industrial)


- WELL COMPLETION DATA:
- (1) diameter (inches) 2"
 - (2) total depth (feet) 41
 - (3) static water level (feet) 31 below top of ground.
 - (4) casing 2" galvanized steel pipe
(material) (depth) pipe
2" (size) if telescope see back.
 - (5) screen 5' 5'
(length) (depth to top)
1 1/4" gauge - CM & Co.
(size) (material)
 - (6) pump 1 5
(HP) (yield gpm)
electric
(type power)
 - (7) electric log 6" 5T rope
(yes or no)
- (organization running log)
- (8) how well bottom plugged Stainer Plug

DRILLERS REMARKS:
Over

OCT 21 1969
MISSISSIPPI BOARD OF WATER COMMISSIONERS

If well telescopes please sketch and show depths.

GROUND LEVEL

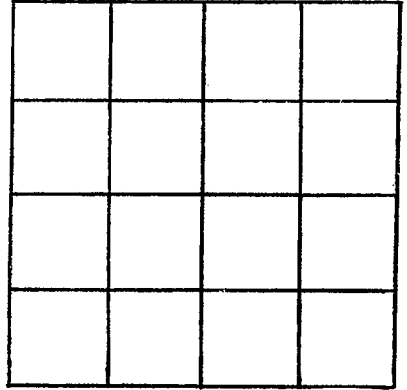

SECTION 36

Please indicate well location X.

ADDITIONAL INFORMATION

Drilled 33 feet 2" pipe
7-5' - Cast screen
out, used was
worked down by
Corker & Wolf Supply
Co. approximately
10 yrs. ago, screen
was OK. Sampled
run in through
hole in pipe

If more than one screen,
show locations of each on sketch.