

Marshall
 D 15
 1-27-70

MISSISSIPPI
 BOARD OF WATER COMMISSIONERS
 416 North State Street
 Jackson, Mississippi 39201

No log
 in file
CODED

WATER WELL DRILLERS LOG

W. A. WATSON
 Water Well Contr.

Marshall

January 27, 1970 date well completed
 W. A. WATSON firm name
 Marshall county well located

LANDOWNER:
 J. W. Tuttle
 Rt. 1
 Byhalia Miss.
 (mailing address)

description of formations encountered
 coarse white
 (under bearing sand)
 from 82 to 100

WELL LOCATION:
 sec. 23 T. 7 N. R. 5 E.
 2 1/4 miles North of Byhalia
 (distance) (direction) (nearest town)

WELL PURPOSE: Home
 (home, irrigation, municipal, industrial)

WELL COMPLETION DATA:
 (1) diameter (inches) 2
 (2) total depth (feet) 100
 (3) static water level (feet) 82 below top of ground.
 (4) casing (material) galv. steel (depth) 97
 2" (size) if telescope see back.
 (5) screen (length) 3' (depth to top) 30"
 2" (size) 60 GAUZE (material)
 (6) pump (HP) 5 (yield gpm)
 electric (type power)
 (7) electric log (yes or no) yes
 (organization running log) C-11 - STRAIN
 (8) how well bottom plugged STRAIN

CODED


JAN 30 1970

MISS. BD. OF
 WATER COMM.

DRILLERS REMARKS:

If well telescopes please sketch and show depths.

GROUND LEVEL

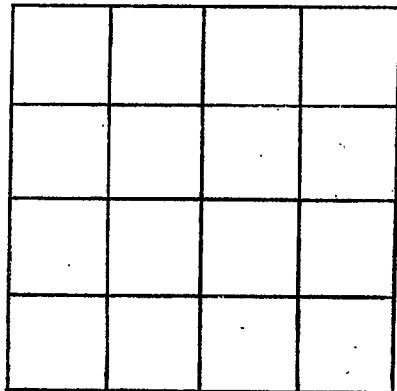

SECTION _____

Please indicate well location X.

ADDITIONAL INFORMATION

*Pulled 2" well
because of hole in
pipe. I put in
new pipe
well originally
made by me Jan 68
Ref Page 243*

If more than one screen,
show locations of each on sketch.