

Marshall  
D 16  
10-19-69

MISSISSIPPI  
BOARD OF WATER COMMISSIONERS  
416 North State Street  
Jackson, Mississippi 39201

Restrained  
GODDARD

WATER WELL DRILLERS LOG

October 19th 1969 W.P. Mason water well contractor Marshall County  
date well completed firm name county well located

LANDOWNER:	description of formations encountered	from	to
R. R. Connor Rt-1 - Bogalia Manr. (mailing address)			
<b>WELL LOCATION:</b> sec. 15 T. 2 N R. 5 E 3 miles NW of Bogalia (distance) (direction) (nearest town)			
<b>WELL PURPOSE:</b> Home (home, irrigation, municipal, industrial)			
<b>WELL COMPLETION DATA:</b> (1) diameter (inches) 2" (2) total depth (feet) 111 feet (3) static water level (feet) 103' below top of ground. (4) casing (material) 2" galvanized steel pipe (depth) 108' (5) screen (size) 2" (length) 3' - 3' (depth to top) (6) pump (HP) 1 (yield gpm) 5 (type power) electric (7) electric log yes (yes or no) (organization running log) 6" stroke (8) how well bottom plugged contractor			
<b>DRILLERS REMARKS:</b> over			

GODDARD

OCT 21 1969


MISS. BD. OF WATER COMMISSIONERS

1969

MISS. BD. OF WATER COMMISSIONERS

If well telescopes please sketch and show depths.

GROUND LEVEL

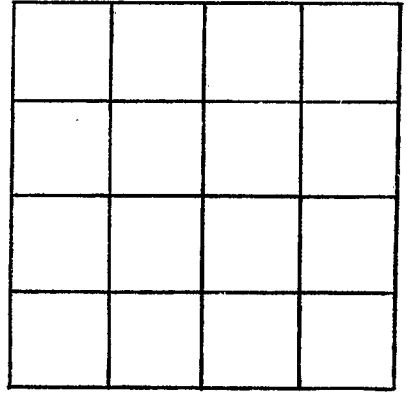

SECTION 15

Please indicate well location X.

ADDITIONAL INFORMATION

*Restraint creep  
made by creep  
August 1963 - 1st of  
Page 134 + Restraint  
April 1964 Ref P-157*

If more than one screen,  
show locations of each on sketch.

*301*