

MISSISSIPPI
 BOARD OF WATER COMMISSIONERS
 416 North State Street
 Jackson, Mississippi 39201

CODED

WATER WELL DRILLERS LOG

Marshall
D17
4-23-70

April 23 19 70 R. L. Carpenter Marshall
 date well completed firm name county well located

LANDOWNER: William Castleburg
Byhalia, Miss.
 (mailing address)

description of formations encountered	from	to
<u>Surface Soil</u>	<u>0</u>	<u>15</u>
<u>Fine Red Sand</u>	<u>15</u>	<u>45</u>
<u>Med. Brown Sand</u>	<u>45</u>	<u>72</u>
<u>Med. White Sand</u>	<u>72</u>	<u>95</u>
<u>White Clay</u>	<u>95</u>	<u>103</u>
<u>White Coarse Sand</u>	<u>103</u>	<u>127</u>

WELL LOCATION:
 sec 35 T 2 N R 5 E
1/4 miles South of Byhalia
 (distance) (direction) (nearest town)

WELL PURPOSE: Home
 (home, irrigation, municipal, industrial)

WELL COMPLETION DATA:

- (1) diameter (inches) 4
- (2) total depth (feet) 127
- (3) static water level (feet) 62 below above top of ground.
- (4) casing Plastic, 121 ft.
 (material) (depth)
 (size) if telescope see back.
- (5) screen 6 ft., 121 ft.
 (length) (depth to top)
4 in. Plastic & Bavel
 (size) (material)
- (6) pump 3/4 12
 (HP) (yield gpm)
Elec.
 (type power)
- (7) electric log no
 (yes or no)

CODED

(organization running log) Plastic Plug

(8) how well bottom plugged

JUL 13 1970


MISS. BD. OF
 WATER COMM.

DRILLERS REMARKS:

If well telescopes please sketch and show depths.

GROUND LEVEL

R5W

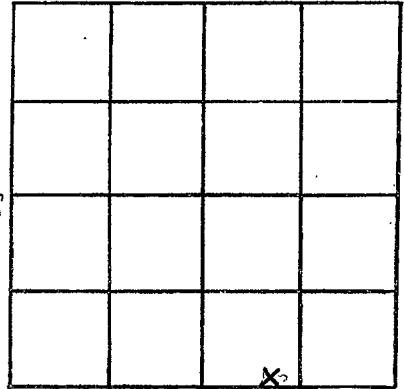

SECTION 35

Please indicate well location X.

ADDITIONAL INFORMATION

If more than one screen, show locations of each on sketch.