

D 24  
7-23-63

WATER WELL DRILLERS LOG

CODED

Date: 7-23, 1963, Driller: Adam B. Co. Inc. County: Marshall  
(Name)

(1) Owner of Land: Robert Barrett  
(Name)  
Byhalia  
(Address)  
27 25  
(2) Location: 1/4, 1/4, Sec. T R  
miles of  
(distance) (direction) (Nearest Town)  
(3) Topography:  
(Hilly) (Flat) (Level)  
(4) Purpose of Well:  
(Domestic Irrigation  
Municipal, Industrial, Other)


Description & Color of Materials Sand, Clay, Red Clay, Shell, etc.	Thick- ness Feet	Depth Feet
top soil	0-20	
red sand	20-55	
clay	55-60	
fine white sand	60-94	
good coarse sand	94-111	

Information upon completion of well:

(1) Diameter: 4 inches.  
(2) Total Depth: 111 feet.  
(3) Water Level: 70 feet below top of ground.  
(4) Cased to: 104, Size  
(5) Screen: Size 4", Length 7'  
(6) Were any formations sealed against pollution?  
yes, no.

If YES depth of formation  
Why  
Drillers Remarks:

CODED

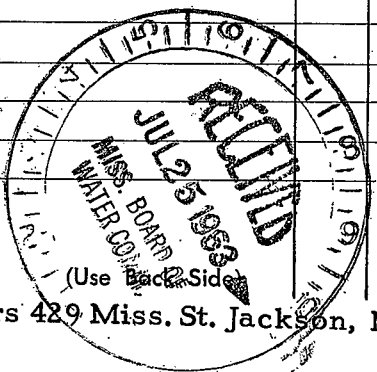

Well No.

