

D25
6-22-64

WATER WELL DRILLERS LOG

CODED

Date: 6-22, 1964, Driller: Abco of Independence County Marshall
(Name)

(1) Owner of Land: Preston Duncan
(Name)

Byhalia Rte 1 Box 66
(Address)

(2) Location: 36 25
1/4, 1/4, Sec. T R
miles _____ of _____
(distance) (direction) (Nearest Town)

(3) Topography: _____
(Hilly) (Flat) (Level)

(4) Purpose of Well: _____
(Domestic Irrigation
Municipal, Industrial, Other)

Description & Color of Materials Sand, Clay, Red Clay, Shell, etc.	Thick- ness Feet	Depth Feet
<u>Top soil</u>	<u>0</u>	<u>15</u>
<u>red sand</u>	<u>15</u>	<u>40</u>
<u>fine white sand</u>		
<u>clay strip</u>	<u>40</u>	<u>80</u>
<u>coarse white sand</u>	<u>80</u>	<u>100</u>

Information upon completion of well:

(1) Diameter 4 inches.

(2) Total Depth 100 feet.

(3) Water Level 63 feet below top of ground.

(4) Cased to 93, Size 4

(5) Screen: Size 4, Length 7


(6) Were any formations sealed against pollution?
_____ yes, _____ no.

If YES depth of formation _____

Why _____

Drillers Remarks: _____

CODED

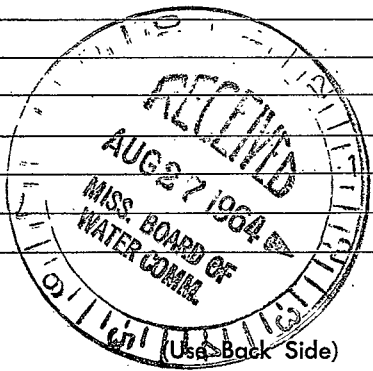

Well No.

