

D28
7-24-64

WATER WELL DRILLERS LOG

CODED

Date: 7-24, 1964, Driller: absco of Independence County Marshall
(Name)

(1) Owner of Land: W.C. Meeks
(Name)

B yhalia
(Address)

(2) Location: 15 25
1/4, 1/4, Sec. T R
_____ miles _____ of _____
(distance) (direction) (Nearest Town)

(3) Topography: _____
(Hilly) (Flat) (Level)

(4) Purpose of Well: _____
(Domestic Irrigation
Municipal, Industrial, Other)

Information upon completion of well:

(1) Diameter 4 inches.

(2) Total Depth 140 feet.

(3) Water Level 80 feet below top of ground.

(4) Cased to 133, Size _____

(5) Screen: Size 4, Length 7

(6) Were any formations sealed against pollution?
_____ yes, _____ no.


If YES depth of formation _____

Why _____

Drillers Remarks: _____

Description & Color of Materials Sand, Clay, Red Clay, Shell, etc.	Thick- ness Feet	Depth Feet
<u>top soil</u>	<u>0</u>	<u>20</u>
<u>clay + sand</u>	<u>20</u>	<u>80</u>
<u>fine white sand</u>	<u>80</u>	<u>125</u>
<u>good coarse</u>		
<u>white sand</u>	<u>125</u>	<u>140</u>

CODED

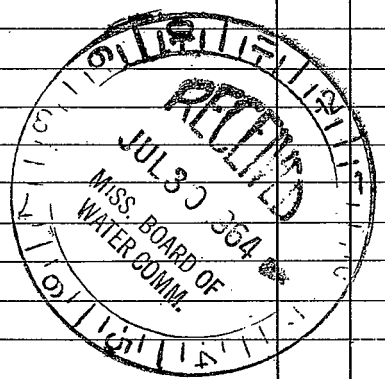

(Use Back Side)

Well No.

[The page contains extremely faint and illegible text, likely bleed-through from the reverse side of the document. No specific content can be transcribed.]