

MARSHALL
D32
2-67

MISSISSIPPI
BOARD OF WATER COMMISSIONERS
416 North State Street
Jackson, Mississippi 39201

WATER WELL DRILLERS LOG

CODED

2-10 1969 date well completed
Leah Well Co firm name
Marshall county well located

LANDOWNER:

Archer

description of formations encountered

from to

Byhalia miss.
(mailing address)

| | | |
|--------------------|-----|-----|
| Red clay | 1 | 30 |
| Sand & gravel | 30 | 58 |
| Blue clay | 50 | 101 |
| Fine white sand | 101 | 118 |
| Water Bearing Sand | 118 | 138 |

WELL LOCATION:


sec 27 T 2 N R 5 E
2 1/2 miles West of Byhalia
(distance) (direction) (nearest town)

WELL PURPOSE: home
(home, irrigation, municipal, industrial)

WELL COMPLETION DATA:

- (1) diameter (inches) 4"
- (2) total depth (feet) 138
- (3) static water level (feet) 118 below top of ground.
- (4) casing Plastic, 132 (material), (depth)
- (size) if telescope see back.
- (5) screen 6' 132' (length), (depth to top)
- 4" Plastic (size), (material)
- (6) pump 1/2 600 gph (HP), (yield gpm)
- Elec. 220V. (type power)
- (7) electric log no (yes or no)
- (organization running log)
- (8) how well bottom plugged Plastic Cap

CODED

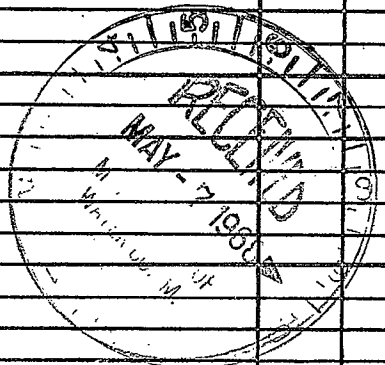

DRILLERS REMARKS:

Good Water Supply

If well telescopes please sketch and show depths.

GROUND LEVEL

| | | | |
|---|--|--|--|
| | | | |
| X | | | |
| | | | |
| | | | |

SECTION 27

Please indicate well location X.

ADDITIONAL INFORMATION

If more than one screen, show locations of each on sketch.