

Marshall
AD 33
7-68

MISSISSIPPI
 BOARD OF WATER COMMISSIONERS
 416 North State Street
 Jackson, Mississippi 39201

CODED

WATER WELL DRILLERS LOG

date well completed July 25, 1968 firm name Burgess Well Co. county well located Marshall

LANDOWNER: B. S. Kingford
Barton, Miss

description of formations encountered	from	to
	<u>gravel</u>	<u>0</u>
<u>sand</u>	<u>50</u>	<u>170</u>

(mailing address)

WELL LOCATION:

sec. 3 T 2 N R 5 E
2 miles SE of Barton
 (distance) (direction) (nearest town)


WELL PURPOSE:

(home, irrigation, municipal, industrial)

WELL COMPLETION DATA:

- diameter (inches) 4"
- total depth (feet) 170
- static water level (feet) 110 ^(below) _(above) top of ground.
- casing plastic, 164 ft.
 (material) (depth)
no if telescope see back.
 (size)
- screen 6 ft., 164 ft.
 (length) (depth to top)
008, gravel wall
 (size) (material)
- pump 3/4, 10 gpm
 (HP) (yield gpm)
Elect.
 (type power)
- electric log (yes or no)
 (organization running log)
- how well bottom plugged plastic plug


CODED

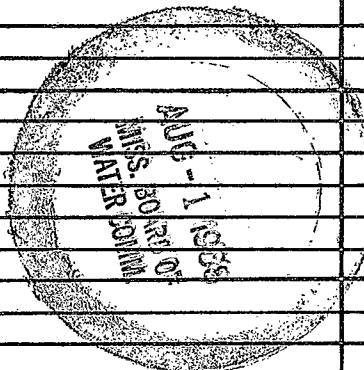

DRILLERS REMARKS:

If well telescopes please sketch and show depths.

GROUND LEVEL

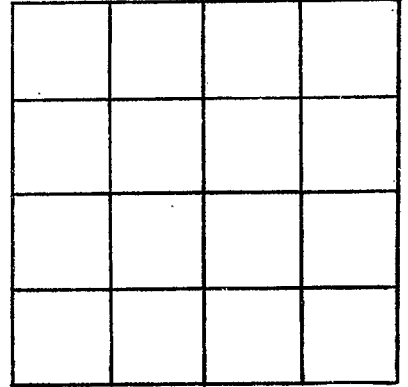

SECTION _____

Please indicate well location X.

ADDITIONAL INFORMATION

If more than one screen,
show locations of each on sketch.